

CORNER RECORD

Document Number CR-14-150City of STOCKTONCounty of SAN JOAQUIN, CaliforniaBrief Legal Description MONUMENT AT THE INTERSECTION OF ARCH ROAD AND FITE COURT
LOCATED IN THE EAST HALF OF SECTION 28, T.1N, R.7E, M.D.B.&M.

CORNER TYPE

COORDINATES (Optional)

NW 1/4	NE 1/4
SW 1/4	SE 1/4

Government Corner	<input type="checkbox"/>	Control	<input type="checkbox"/>
Meander	<input type="checkbox"/>	Property	<input type="checkbox"/>
Rancho	<input type="checkbox"/>	Other	<input checked="" type="checkbox"/>

N _____
E _____
Zone _____ NAD27 ☐ NAD83 ☐
NAD83 Epoch _____
Elev. _____
Vert. Datum: NVGD29 ☐ NVGD88 ☐
Meas. Units: Metric ☐ Imperial ☒

SEC. 28 T.1N, R.7E

Date of Survey 5-2-2014Corner— Left as found ☒ Found and tagged ☐ Established ☐ Reestablished ☐ Rebuilt ☐

Identification and type of corner found: Evidence used to identify or procedure used to establish or reestablish the corner:
FOUND 3/4" IRON PIN NOT TAGGED IN MONUMENT WELL, AT THE INTERSECTION OF ARCH ROAD AND
FRONTIERWAY LOCATED IN THE EAST HALF OF SECTION 28, T.1N, R.7E, M.D.B.&M. FOUND MONUMENT AS
SHOWN ON PARCEL MAP FILED IN BOOK 21 OF PARCEL MAPS AT PAGE 196, SAN JOAQUIN COUNTY
RECORDS.

A description of the physical condition of the monument as found and as set or reset: _____
MONUMENT IS IN AREA OF RECONSTRUCTION, SET TIES AS SHOWN ON PAGE 2.

SURVEYOR'S STATEMENT

This Corner Record was prepared by me or under my direction in conformance with
the Land Surveyors' Act on JUNE 5, 2014,


Signed [Signature] P.L.S. or R.C.E. Number 6953

COUNTY SURVEYOR'S STATEMENT

This Corner Record was received June 17, 2014 and examined
and filed August 6, 2014

Signed [Signature] P.L.S. or R.C.E. No: 26994Title County Surveyor

County Surveyor's Comment _____

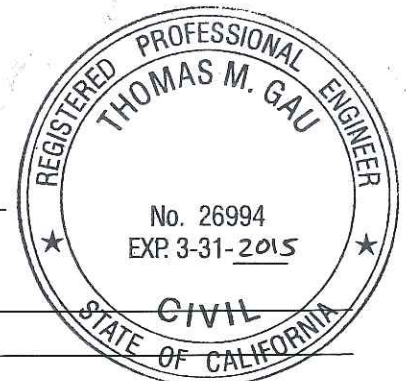

LEGEND:

- ⊗ SET MONUMENT AS NOTED
- FOUND MONUMENT AS NOTED.
- S.J.C.R. DENOTES SAN JOAQUIN COUNTY RECORDS
- P.M. DENOTES PARCEL MAP
- (M) MEASURED DISTANCE. ALL DISTANCES ARE MEASURED UNLESS NOTED OTHERWISE.

REFERENCE:

(R1) P.M. 21-196, S.J.C.R.

