
CORNER RECORD

CORNER	RECORD	Document	Number CR-14-153
City of	STOCKTON		SAN JOAQUIN Californ
80		ECTION OF ARCH	ROAD AND LOGISTICS DRIVE
	LOCATED IN SECTION 27, T.		
	CORNER TYP	PΕ	COORDINATES (Optional)
NW NE	Government Corner C	ontrol	N
1/4 1/4		roperty	ENAD27
SW SE		ther 🔀	NAD83 Epoch
1/4 1/4	35.00 (A)		Elev.
SEC. 27 T.1N, R.7E	Date of Survey5—	2-2014	Vert. Datum: NVGD29 NVGD88 Meas. Units: Metric Imperial
Corner— Left as fou	nd 🔀 Found and tagged [Established [Reestablished Rebuilt
dentification and type of c	corner found: Evidence used to	identify or proced	ure used to establish or reestablish the co
MONUMENTS AS SHOWN	I ON PACE 2		
A description of the physic	al condition of the monument a	s found and as s	et or reset:
MONUMENTS ARE IN A	N AREA OF RECONSTRUCTION,	, SET TIES AS S	HOWN ON PAGE 2.
			1
8			
	SURVEYOR'S STATEMEN	IT	ice with
This Corner Record was pr	repared by me or under my direc	ction in conformar	ice with
the Land Surveyors' Act or	. JUNE 5	2014	KENT A. Y
the Land Surveyors Act of) 00NL 0	,2014,	(\ N□. 6953)
			 ★ Nd. 8933 ★
1	/		SATE STATE
Signed	P.L.S. or R.C	C.E. Number	6953 OF CALIFORNIA
	COUNTY SURVEYOR'S STAT		PROFESSIONAL
This Corner Record was re	eceived June 17	, 2014	and examined RED ON AS M. G.
and filed July =	30 ,2014	_	
Signed Thomas	n. Fran PLS. or F	R.C.E. No:	6994
	rveyor		No. 26994 EXP. 3-31-2015
•	ent		
(OF CALIFORNIA
(-			
·			

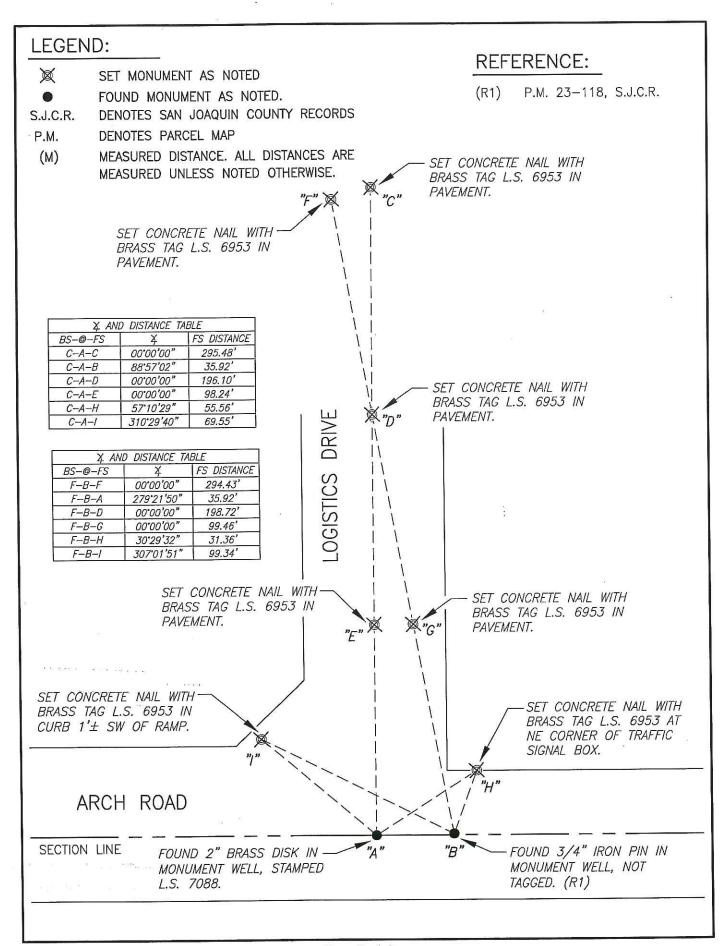

Page 2 of 2