
## CORNER RECORD Document Number \_ CR-14-19 City of \_\_\_\_\_ County of San Joaquin, California Brief Legal Description Telegraph Avenue (165' +/- and 230' +/- West of Delano Avenue) (WITHIN SECTION 32, TOWNSHIP 2 NORTH, RANGE 6 EAST, MOUNT DIABLO BASE & MERIDIAN) CORNER TYPE COORDINATES (Optional) Government Corner Confrol Zone\_ \_NAD27 🗆 NAD83 🗖 Meander Property NAD83 Epoch Rancho Other Elev. Vert. Datum: NGVD29 $\square$ NAVD88 Date of Survey August 13, 2014 Meas. Units: Metric Imperial 🖾 Left as found ☐ Found and tagged ☐ Established ☐ Corner -Reestablished 🖾 Rebuilt 🖂 Identification and type of corner found: Evidence used to identify or procedure used to establish or reestablish the corner: SEE SKETCH ON BACKSIDE. A description of the physical condition of the monument as found and as set or reset:\_\_\_\_ SEE SKETCH ON BACKSIDE. SURVEYOR'S STATEMENT This Corner Record was prepared by me or under my direction in conformance with the Land Surveyors' Act on August 22 , 2014. \_\_\_\_ P.L.S. Number\_<u>8657</u> COUNTY SURVEYOR'S STATEMENT This Corner Record was received August 22, 2014 and examined and filed September Signed Momas M. R.C.E. No. 26994 Title County Surveyor County Surveyor's Comment\_\_\_\_\_ No. 26994 (D.D. Sheet No. 30A) (Job No. 580206)



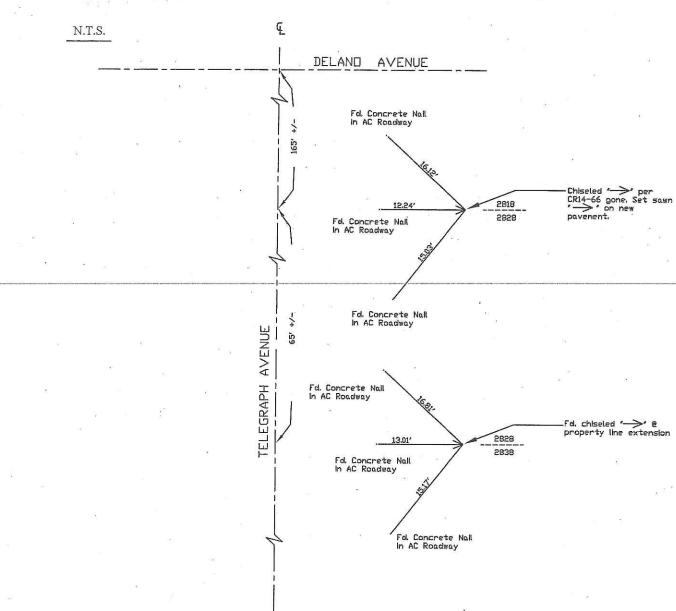

Note: Found Monuments are not tagged unless otherwise noted.

"No Attempt Was Made to Verify the Monument(s)"

Set=Conc. Nail with Brass Washer Stamped
"S.J. Co.", unless otherwise noted
Fd.=Found Conc. Nail with Brass Washer Stamped
"S.J. Co.", unless otherwise noted
CR=Corner Record
FP=Fence Post
JP=Joint Pole
LP=Light Pole
LP=Light Pole
SP=Service Pole
TP=Telephone Pole
SF.N.=Searched Found Nothing
N.T.S.=Not To Scale
M&P=Maps & Plats
PM=Parcel Map
RS=Record of Survey
FB=Field Book