
CORNER RECORD

CORNER	KECOKD	Document Nur	mber	80
City of		County of SA		, California
Brief Legal Description	TRACT OF LAND IN THE NORTH	H 1/2 OF SEC. 2, T	r.2S., R.6E., M.D.B.&M.	- X
	CORNER TYPE	·	COORDINATES(O	
	Government Corner Control Meander Property		NAD2	
	Rancho Other	□ N	AD83 Epoch	
	Date of Survey October 2, 2014	v	ert. Datum: NGVD29	NADV88 Imperial
Corner - Left as found	Found and tagged	Established	Reestablished 🗶	Rebuilt
	er found: Evidence used to identify or p			
	HING. SET SURVEY MONUMEN			
PARCEL MAP, BOOK 10,	PAGE 139, RECORD OF SURVE	Y BOOK 4, PAGE	140 AND LOCATING TH	IE CENTER
LINE OF THE EXISTING F	RAILROAD TRACK, SEE ATTACH	ED PLAT.	v	
			· ·	
This Corner Record was pr	SURVEYOR'S STATEMENT repared by me or under my direction	n in conformance v	with Strategy	Y CANOSUME
the Land Surveyor's Act on	OCTOBER 2 , 2		EXP	1231-14
Signed	P.L.S. or R.C.E. No	o.: _L.S. 7600	- Prico	CALIFORN
	COUNTY SURVEYOR'S STATEMEN	τ'		OFESSIONAL
	ived November 4,	2014 and 6	examined	MASM
and filed November	M. Han PLS. or R.C.E.	No: 7699	FEGISTION	WAG W. GALER
Title County Sur		110 <u></u>		lo. 26994
County Surveyor's Com		-		9: 3-31- <u>2015</u>
				OF CALIFORNIA

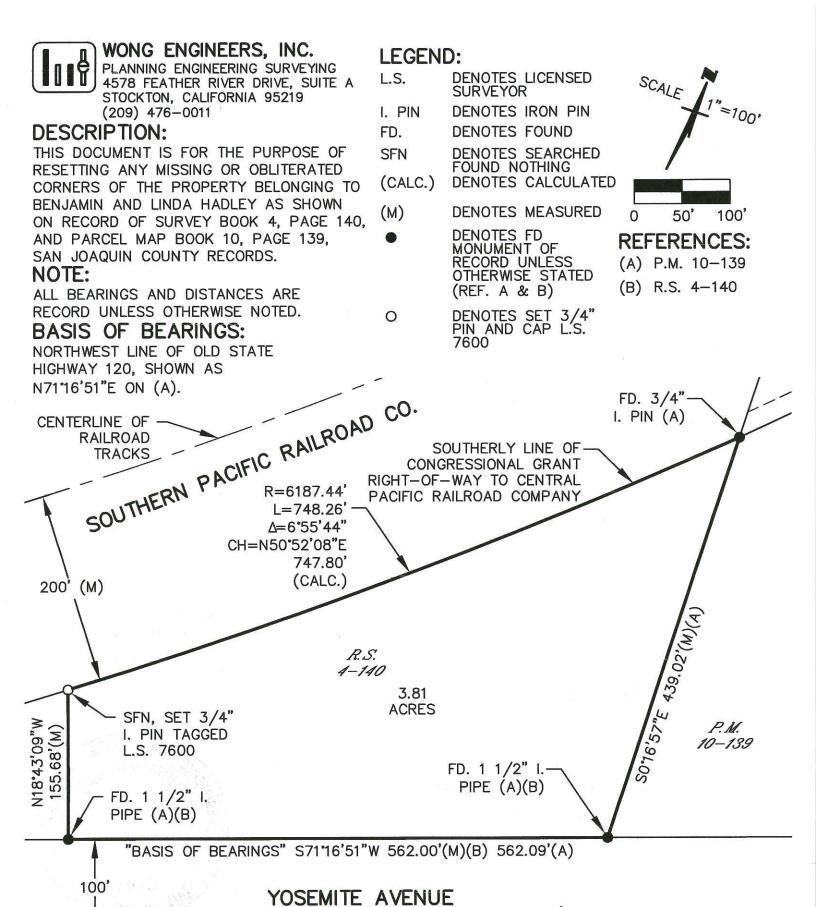

(OLD STATE HIGHWAY ROUTE NO. 120)