


CORNER RECORD

Document Number CR-15-01

City of Lathrop

County of San Joaquin, California

Brief Legal Description Monuments East of I-5, West of Harland Road and North of Louise Avenue

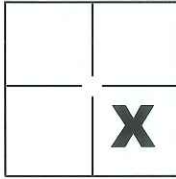

CORNER TYPE

Government Corner Control
 Meander Property
 Rancho Other

COORDINATES(Optional)

N. _____
 E. _____
 Zone _____ NAD27 NAD83
 NAD83 Epoch _____
 Elev. _____
 Vert. Datum: NGVD29 NADV88
 Meas. Units: Metric Imperial

Sec. 27, T.1S., R.6E.,
M.D.B. & M.

Date of Survey November 19, 2014

Corner - Left as found Found and tagged Established Reestablished Rebuilt

Identification and type of corner found: Evidence used to identify or procedure used to establish or reestablish the corner:

See Sheet 2

A description of the physical condition of the monument as found and as set or reset: _____

See Sheet 2

SURVEYOR'S STATEMENT

This Corner Record was prepared by me or under my direction in conformance with the Land Surveyor's Act on Nov. 24, 2014.

Signed Michael L. Quarlaton P.L.S. or R.C.E. No.: _____ L.S. 4450




COUNTY SURVEYOR'S STATEMENT

This Corner Record was received January 7, 2015 and examined and filed January 9, 2015.

Signed Warren D. Smith P.L.S. or R.C.E. No.: 4842

Title Acting County Surveyor

County Surveyor's Comment _____

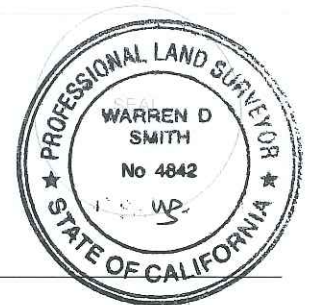

LEGEND

- INDICATES FOUND MONUMENT AS NOTED
- ✕ INDICATES FOUND 1" IRON PIPE W/PLASTIC CAP STAMPED "CALIF DOT", NO REFERENCE
- INDICATES SET MONUMENT AS NOTED
- FD. INDICATES FOUND ON THIS SURVEY
- (M) INDICATES MEASURED THIS SURVEY
- R.S. INDICATES RECORD OF SURVEY, BOOK AND PAGE, S.J.C.R.
- S.J.C.R. INDICATES SAN JOAQUIN COUNTY RECORDS

STATEMENT OF PURPOSE

THE PURPOSE OF THIS SURVEY IS TO IDENTIFY AND RECORD THE LOCATION OF EXISTING MONUMENTS PRIOR TO THE CONSTRUCTION OF NEW IMPROVEMENTS AROUND THE MONUMENTS. IT IS ALSO INTENDED TO PERPETUATE AND PRESERVE THE LOCATION OF MONUMENTS THAT MAY BE DISTURBED OR DESTROYED DURING CONSTRUCTION AND IT IS NOT THE PURPOSE OF THIS SURVEY TO MAKE PROPERTY LINE DETERMINATIONS. PARCEL LINES SHOWN HEREIN ARE FOR GENERAL LOCATION AND INFORMATION PURPOSES ONLY.

REFERENCE

(A) R.S. 37-17, S.J.C.R.



SCALE: 1" = 50'

S89°30'29"E (M)
127.44'(M)

FD. 3/4" CAPPED IRON PIPE
STAMPED "L.S. 4663" PER (A)
ADJACENT TO 1" IRON PIPE

N09°03'06"E (M)
101.15'(M)

FD. 3/4" REBAR, NO
REFERENCE, N75°20'35"W
0.58'(M) FROM THE 1"
IRON PIPE

139.65'(M)
N89°34'24"W (M)

FD. SPIKE AND WASHER
STAMPED "L.S. 4663" PER (A),
S02°07'20"W 0.27'(M) FROM 1"
IRON PIPE

R.S. 37-17

FD. 1" IRON PIPE, NOT
TAGGED, NO REFERENCE

S02°06'38"W (M)
208.28'(M)

S12°37'23"W (M)
141.45'(M)

N11°54'11"W (M)
124.29'(M)

S21°03'15"W (M)
92.71'(M)

99.90'(M)
S02°07'20"W (M)

HARLAN ROAD

ROAD

HARLAN ROAD

SET SURV. SPIKE
W/BRASS WASHER
STAMPED L.S. 4450

SET BRASS DISC
STAMPED "L.S. 4450
AT TOP OF CURB

LOT "B" M. & P. 29-15

R.S.
33-110