


CORNER RECORD

Document Number CR-15-02

City of City of Stockton

County of San Joaquin, California

Brief Legal Description Lot 5 and Portion of Lot 6 per P. M. 5-130, S.J.C.R.

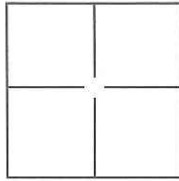

Sec. 6 in
C.M. Weber Grant

CORNER TYPE

Government Corner Control
 Meander Property
 Rancho Other

Date of Survey December 13, 2014

COORDINATES(Optional)

N. _____
 E. _____
 Zone _____ NAD27 NAD83
 NAD83 Epoch _____
 Elev. _____
 Vert. Datum: NGVD29 NADV88
 Meas. Units: Metric Imperial

Corner - Left as found Found and tagged Established Reestablished Rebuilt

Identification and type of corner found: Evidence used to identify or procedure used to establish or reestablish the corner:

See Sheet 2

A description of the physical condition of the monument as found and as set or reset:

See Sheet 2

SURVEYOR'S STATEMENT

This Corner Record was prepared by me or under my direction in conformance with the Land Surveyor's Act on JAN 5, 2015.

Signed Michael L. Quartaroli P.L.S. or R.C.E. No.: L.S. 4450



COUNTY SURVEYOR'S STATEMENT

This Corner Record was received January 7, 2015 and examined and filed January 20, 2015.

Signed Warren D. Smith P.L.S. or R.C.E. No.: 4842

Title Acting County Surveyor
 County Surveyor's Comment _____






SCALE: 1" = 50'

BEVERLY

PLACE

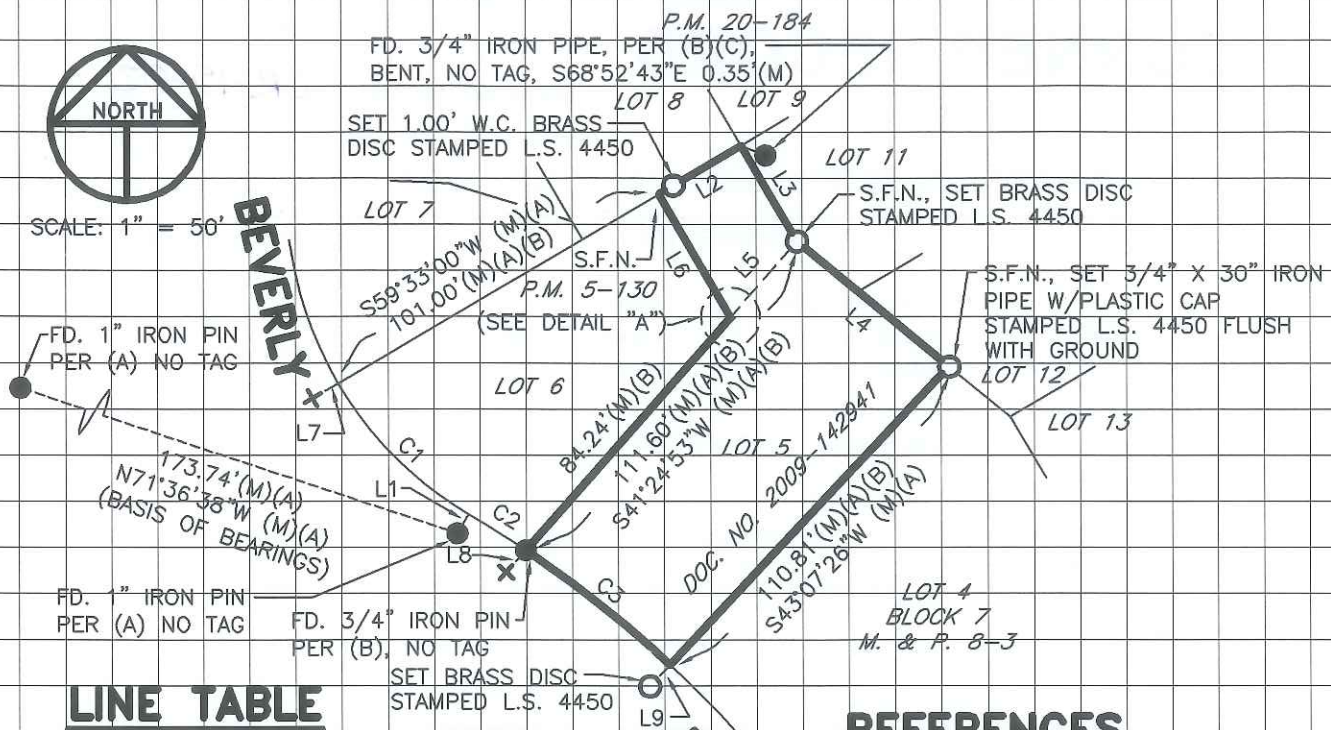

LINE TABLE

LINE	BEARING	DISTANCE
L1	S30°30'42"W (M)(A)	6.00'(M)(B)
L2	S59°33'00"W (M)(A)(B)	26.00'(M)(B)
L3	S30°27'00"E (M)(A)	30.00'(M)(A)(B)
L4	S50°24'57"E (M)(A)	53.21'(M)(A)(B)
L5	S41°24'53"W (M)(A)(B)	27.36'(M)(B)
L6	S30°27'00"E (M)(A)(B)	38.52'(M)(B)
L7	S59°33'00"W (M)(B)	4.00'(M)(B)
L8	S41°24'53"W (M)(B)	4.00'(M)(B)
L9	S43°07'26"W (M)	4.00'(M)
L10	S30°27'00"E (M)	1.00'(M)
L11	N41°24'53"E (M)	1.00'(M)

REFERENCES

- (A) M. & P. 8-3, S.J.C.R.
- (B) P.M. 5-130, S.J.C.R.
- (C) P.M. 20-184, S.J.C.R.

CURVE TABLE

C1	R=100.00' L=50.68' Δ=29°02'17" CH=S44°58'10"E 50.14'	C3	R=310.00' L=50.00' Δ=9°14'29" CH=N51°29'49"W 49.95'
C2	R=310.00' L=18.24' Δ=3°22'15" CH=N57°48'11"W 18.24'		

LEGEND

- INDICATES FOUND MONUMENT AS NOTED
- INDICATES SET MONUMENT AS NOTED
- ✚ INDICATES FOUND CHISELED CROSS PER (B)
- FD. INDICATES FOUND ON THIS SURVEY
- (M) INDICATES MEASURED THIS SURVEY
- R.S. INDICATES RECORD OF SURVEY, BOOK AND PAGE, S.J.C.R.
- S.J.C.R. INDICATES SAN JOAQUIN COUNTY RECORDS

BASIS OF BEARINGS

THE BASIS OF BEARINGS FOR THIS SURVEY IS THE TIE LINE BETWEEN THE TWO FOUND 1" IRON PINS SHOWN ON M. & P. 8-3 AS N.71°36'38"W.

