
## **CORNER RECORD**

CORNER RECORD	Document Number CR-15-42
City of LODI	County of SAN JOAQUIN, California
Brief Legal Description MONUMENT AT THE NORTHWEST	
LOCATED IN THE NORTHEAST QU	UARTER OF SECTION 12, T.3N, R.6E, M.D.B.&M.
CORNER TYPE	COORDINATES (Optional)
NW NE 1/4 Government Corner Contr	
Meander Prope	100 Sept. 100 Se
SW   SE   Rancho   Other   1/4   1/4	NAD83 Epoch
SEC. 12 T.3N, R.6E Date of Survey	−2015 Vert. Datum: NVGD29 NVGD88
	Meas. Units: Metric 🗌 Imperial 🗵
Corner− Left as found ★ Found and tagged □	Established Reestablished Rebuilt
Identification and type of corner found: Evidence used to iden	ntify or procedure used to establish or reestablish the corner:
FOUND 3/4" IRON PIN WITH PUNCH MARK APPROXIMATELY ±0.25' BELOW PAVEMENT AT THE NORTHWEST	
CORNER OF CHEROKEE LANE AND HILBORN STREET LOCATED IN THE NORTHEAST QUARTER OF SECTION 12,	
T.3N, R.6E, M.D.B.&M. NO RECORD OF FOUND MONUMENT.	
A description of the physical condition of the monument as found and as set or reset:	
•	
SURVEYOR'S STATEMENT	
SURVEYOR'S STATEMENT  This Corner Record was prepared by me or under my direction in conformance with	
the Land Surveyors' Act onMARCH 25,_	
3	*
Signed P.L.S. or R.C.E. N	Number 6953
COUNTY SURVEYOR'S STATEME	INT
This Corner Record was receivedMavch_30	SONAL LAND S
and filed April 17 2015	
Sinual NA - A transfer DIS or BCE No. 4842	
Title Acting County Surveyor	
County Surveyor's Comment	

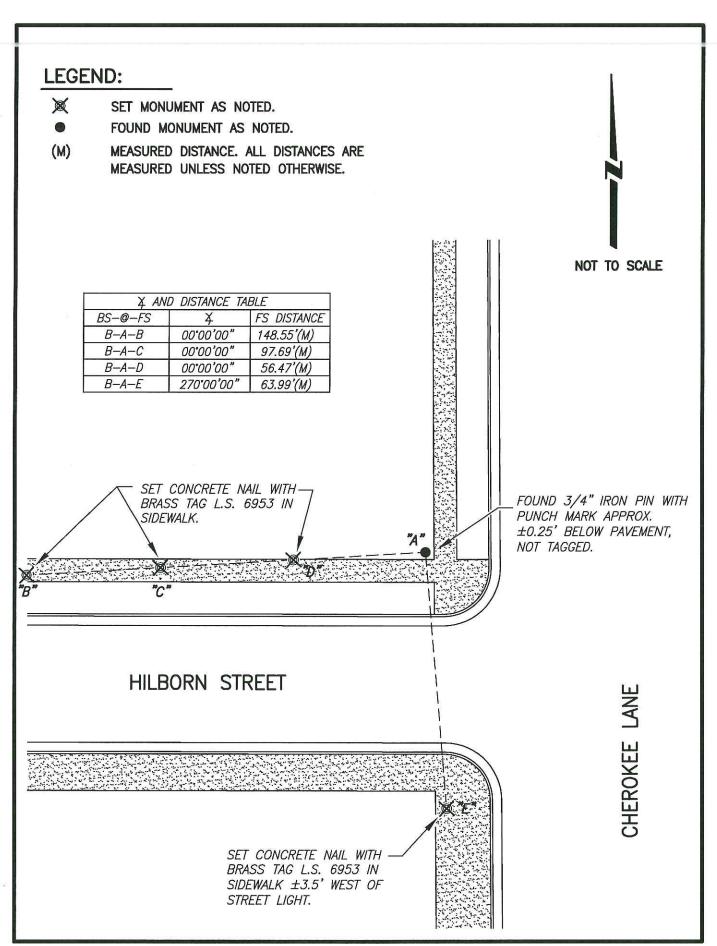

Page 2 of 2