
CORNER RECORD

CORNER RECORD	Document Number <u>(</u>	D-15-43
City of LODI	County of SAN J	DAQUIN , California
Brief Legal Description MONUMENT ON THE SOUTH S		
MAIN STREET. LOCATED IN SE	CTION 1, T.3N, R.6E, M.D.B.8	kМ.
CORNER TYPE		ORDINATES (Optional)
NW NE Government Corner Corner Corner		
Meander Pro	perty Zone	NAD27 NAD83
SW SE Rancho □ Oth	_	h
SEC. 1 T.3N, R.6E Date of Survey	Elev 3-2015	: NVGD29 NVGD88
	Meas. Units:	
Corner— Left as found 🔀 Found and tagged 🗌	Established Reesta	blished Rebuilt
Identification and type of corner found: Evidence used to id	entify or procedure used to est	ablish or reestablish the corner:
FOUND CUT "X" IN SIDEWALK ON THE SOUTH SIDE O		
STREET. LOCATED IN SECTION 1, T.3N, R.6E, M.D.B.&	M. NO RECORD OF FOUND M	ONUMENT.
7 TA 2 SS S		
A description of the physical condition of the monument as		
MONUMENT IS IN AREA OF RECONSTRUCTION, SET TIE	S AS SHOWN ON PAGE 2.	
SURVEYOR'S STATEMENT		
		LAND SURIO
This Corner Record was prepared by me or under my direction		KENT A.
the Land Surveyors' Act on MARCH 25	,2015,	HYSELL
-		N□. 6953
Signed P.L.S. or R.C.E.	0057	SATE STREET
Signed P.L.S. or R.C.E.	• Number	UF CALL
COUNTY SURVEYOR'S STATEM	MENT	NA LANC
This Corner Record was received March 30,	2015 and examined	WARREN D CL
and filed April 17 2015		SMITH SMITH
and filed April 17 2015 Signed P.L.S. OF R.C.	E. No: 4842	No 4842
Title Acting County Surveyor		F.F. OF CALIFOR
County Surveyor's Comment		
	# E	9

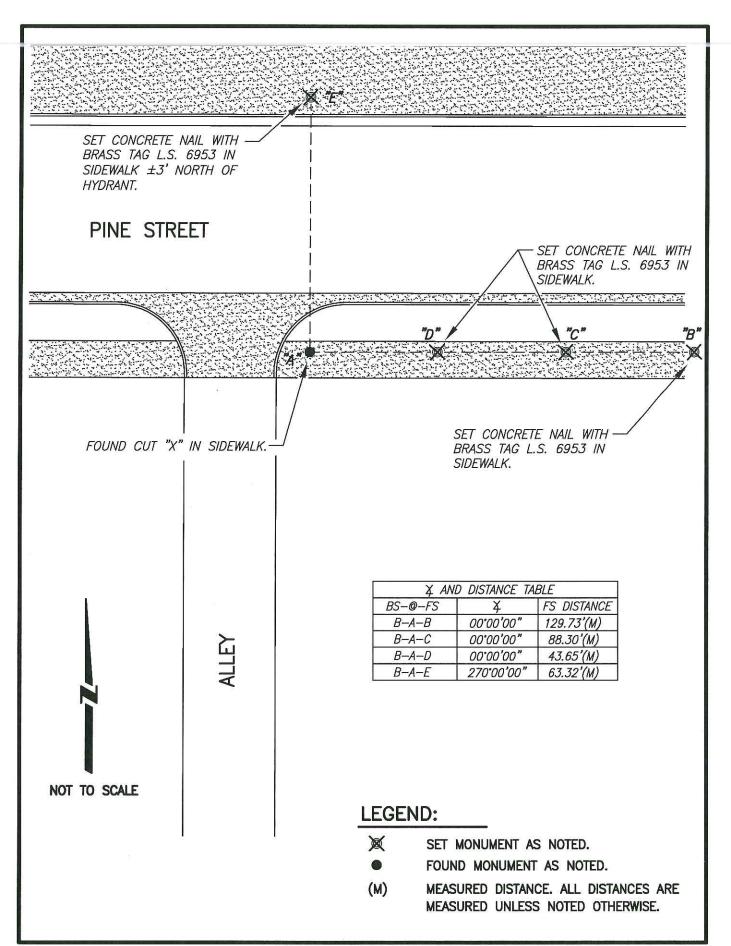

Page 2 of 2