## **CORNER RECORD**


CORNER RECC	JKD <sup>*</sup>		CR-15-44		
City of LODI					
City of LODI  Brief Legal Description MONUMENT AT		*	N JOAQUIN , California		
			T.3N, R.7E, M.D.B.&M.		
	CORNER TYPE		COORDINATES (Optional)		
NW NE	0				
1/4 1/4 Government Meander	Corner Control Property	☐ E ☐ Zone	NAD27 NAD83		
SW SE Rancho	Other	(arresp)	EpochNADZ7 [ NADOS [		
1/4 1/4		Elev.			
SEC. 7 T.3N, R.7E Date of Surv	rey <u>3-23-201</u> 5		atum: NVGD29 NVGD88		
		meds, t	Jnits: Metric 🗌 Imperial 🛚		
Corner— Left as found X Foun	d and tagged 🗌 🛮 Esta	olished Re	eestablished Rebuilt		
Identification and type of corner found: Ev	idence used to identify o	r procedure used to	establish or reestablish the corner:		
FOUND 3/4" IRON PIN, NOT TAGGED	AND FLUSH WITH CON	CRETE WALK AT TI	HE SOUTHEAST CORNER OF		
CHEROKEE LANE AND DELORES STREE					
T.3N, R.7E, M.D.B.&M. NO RECORD OF	FOUND MONUMENT.				
A description of the physical condition of the	ne monument as found c	nd as set or reset:			
MONUMENT IS IN AREA OF RECONSTRU					
		5			
SLIBVEYOR	S'S STATEMENT				
			STATE OF LAND SURE		
This Corner Record was prepared by me or	under my direction in co	onformance with	KENT A.		
the Land Surveyors' Act on MARCH 25 , 2015 , HYSELL					
			N□. 6953		
Signed Saffy	_ P.L.S. or <del>R.C.E.</del> Numbe	r6953	OF CALFOR		
COUNTY SURV	EYOR'S STATEMENT		25 1 4 4 4		
This Corner Record was receivedMarch	30 , 2015	and examin	ed sumai LAND Sug		
and filed April 17	2015		S WARREN D C		
		4047	SMITH \ \ \ \ \ \ \ \ \ \ \ \ \ \ \ \ \ \ \		
Signed Man D. J. J.	P.L.S. or R.C.E. No:	7872	- (g) · · · · /3		
Title <u>Acting County Surveyor</u>			PIFOF CALIFORNIA		
County Surveyor's Comment			TOAL		
			TO STATE OF THE ST		

## LEGEND:

- SET MONUMENT AS NOTED.
- FOUND MONUMENT AS NOTED.
- (M) MEASURED DISTANCE. ALL DISTANCES ARE MEASURED UNLESS NOTED OTHERWISE.

4 AND DISTANCE TABLE			
BS-@-FS	¥	FS DISTANCE	
B-A-B	00'00'00"	145.78'(M)	
B-A-C	00'00'00"	93.54'(M)	
B-A-D	00'00'00"	44.60'(M)	
B-A-E	270'00'00"	27.85'(M)	

## **DELORES STREET**

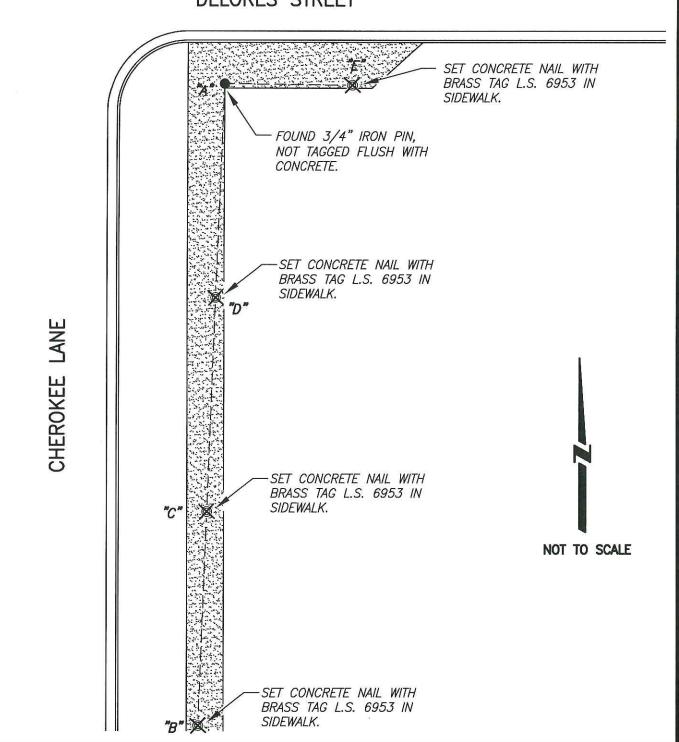

Page 2 of 2