


CORNER RECORD

Document Number CR-15-46

City of _____

County of San Joaquin, California

Brief Legal Description Being all of the 6.005 Ac. parcel and the West line of the 6.256 Ac. parcel as shown on R.S. 22-135.

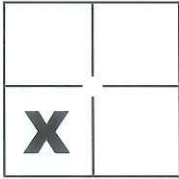

CORNER TYPE

Government Corner Control
 Meander Property
 Rancho Other

COORDINATES(Optional)

N. _____
 E. _____
 Zone _____ NAD27 NAD83
 NAD83 Epoch _____
 Elev. _____
 Vert. Datum: NGVD29 NADV88
 Meas. Units: Metric Imperial

Sec. 8, T.3N., R.6E.,
 M.D.B. & M.

Date of Survey February 28, 2015

Corner - Left as found Found and tagged Established Reestablished Rebuilt

Identification and type of corner found: Evidence used to identify or procedure used to establish or reestablish the corner:

See sheet 2

A description of the physical condition of the monument as found and as set or reset: See sheet 2

SURVEYOR'S STATEMENT

This Corner Record was prepared by me or under my direction in conformance with the Land Surveyor's Act on April 23, 2015.

Signed Michael L. Quarzani P.L.S. or R.C.E. No.: L.S. 4450




COUNTY SURVEYOR'S STATEMENT

This Corner Record was received APRIL 27, 2015 and examined and filed May 4, 2015.

Signed Warren D. Smith P.L.S. or R.C.E. No.: 4842

Title Acting County Surveyor

County Surveyor's Comment _____

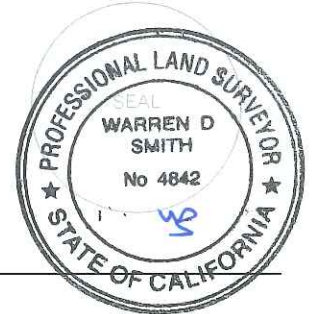

FD. 3/4" REBAR, SET
PLASTIC CAP STAMPED
L.S. 4450, CALLED 3/4"
IRON PIN PER (A)

FD. 3/4" REBAR, SET
PLASTIC CAP STAMPED
L.S. 4450, CALLED 3/4"
IRON PIN PER (A)

S.F.N.

481.61'(M) 481.45'(A)
S88°44'30"E (A)
S88°44'55"E (M)

1/4 1/4
SECTION LINE

REFERENCES


- (A) R.S. 22-135, S.J.C.R.
- (B) R.S. 34-66, S.J.C.R.

BASIS OF BEARINGS

THE BASIS OF BEARINGS FOR THIS SURVEY IS
THE EAST LINE OF THE 6.005 AC. PARCEL,
SHOWN ON R.S. 22-135 S.J.C.R., AS
S.00°01'45"W.


LEGEND

- INDICATES FOUND MONUMENT AS NOTED
- INDICATES SET 1/2" X 30" IRON PIPE
W/PLASTIC CAP STAMPED L.S. 4450
- FD. INDICATES FOUND ON THIS SURVEY
- (M) INDICATES MEASURED THIS SURVEY
- DOC. NO. INDICATES DOCUMENT NUMBER, S.J.C.R.
- R.S. INDICATES RECORD OF SURVEY, BOOK
AND PAGE, S.J.C.R.
- S.J.C.R. INDICATES SAN JOAQUIN COUNTY
RECORDS
- S.F.N. INDICATES SEARCHED FOUND NOTHING

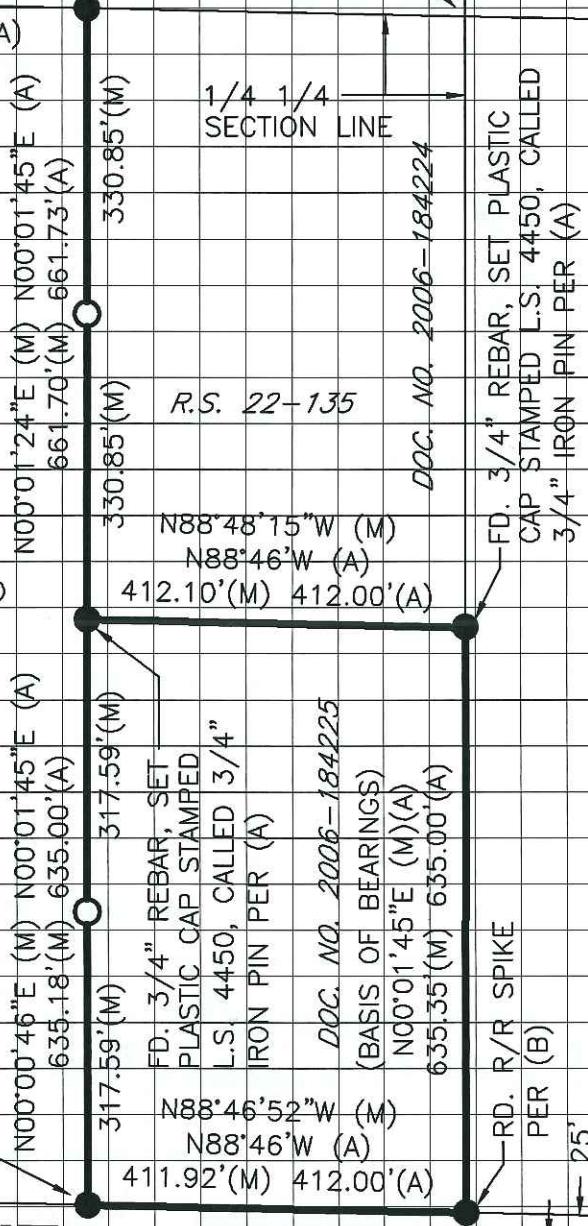

FD. 3/4" REBAR, SET PLASTIC CAP
STAMPED L.S. 4450, CALLED 3/4"
IRON PIN PER (A)

SECTION LINE STATE HIGHWAY NO. 12

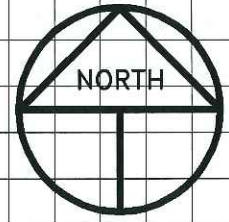

SCALE: 1" = 200'
2014-241