



FOUND CONCRETE NAIL WITH BRASS TAG L.S. 6953 IN SIDEWALK ±3' NORTH OF HYDRANT.(R1)


PINE STREET

FOUND CONCRETE NAIL WITH BRASS TAG L.S. 6953 IN SIDEWALK.(R1)

SET CONCRETE NAIL WITH BRASS TAG L.S. 6953

FOUND CONCRETE NAIL WITH BRASS TAG L.S. 6953 IN SIDEWALK.(R1)

X AND DISTANCE TABLE		
BS-@-FS	X	FS DISTANCE
B-A-B	00°00'00"	129.73'(M)(R1)
B-A-C	00°00'00"	88.30'(M)(R1)
B-A-D	00°00'00"	43.65'(M)(R1)
B-A-E	270°00'00"	63.32'(M)(R1)

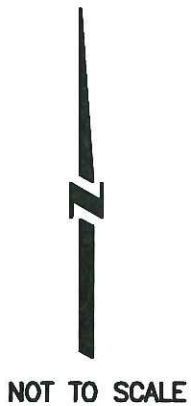

ALLEY

**REFERENCE:**

(R1) C.R. 15-43, S.J.C.R.

**LEGEND:**

- ⊗ SET MONUMENT AS NOTED.
- FOUND MONUMENT AS NOTED.
- C.R. DENOTES CORNER RECORD
- (M) MEASURED DISTANCE. ALL DISTANCES ARE MEASURED UNLESS NOTED OTHERWISE.