

CORNER RECORD

Document Number CR-15-50
County of SAN JOAQUIN, California

City of LODI

Brief Legal Description MONUMENTS AT THE SOUTHEAST CORNER OF TURNER ROAD AND RUTLEDGE DRIVE
LOCATED IN THE NORTHEAST QUARTER OF SECTION 3, T.3N, R.6E, M.D.B.&M.

NW 1/4	NE 1/4
SW 1/4	SE 1/4

CORNER TYPE

Government Corner Control
 Meander Property
 Rancho Other

COORDINATES (Optional)

N _____
 E _____
 Zone _____ NAD27 NAD83
 NAD83 Epoch _____
 Elev. _____
 Vert. Datum: NVGD29 NVGD88
 Meas. Units: Metric Imperial

SEC. 3 T.3N, R.6E

Date of Survey 5-4-2015

Corner— Left as found Found and tagged Established Reestablished Rebuilt

Identification and type of corner found: Evidence used to identify or procedure used to establish or reestablish the corner:
SET MONUMENTS AS SHOWN ON PAGE 2.

A description of the physical condition of the monument as found and as set or reset: _____
MONUMENTS ARE IN AN AREA OF RECONSTRUCTION, SET TIES AS SHOWN ON PAGE 2.

SURVEYOR'S STATEMENT

This Corner Record was prepared by me or under my direction in conformance with
 the Land Surveyors' Act on MAY 5, 2015,



Signed [Signature] P.L.S. or R.C.E. Number 6953

COUNTY SURVEYOR'S STATEMENT

This Corner Record was received May 11, 2015 and examined
 and filed May 21, 2015



Signed [Signature] P.L.S. or R.C.E. No: 4842

Title Acting County Surveyor

County Surveyor's Comment _____

LEGEND:


- ⊗ SET MONUMENT AS NOTED.
- FOUND MONUMENT AS NOTED.
- C.R. DENOTES CORNER RECORD
- (M) MEASURED DISTANCE. ALL DISTANCES ARE MEASURED UNLESS NOTED OTHERWISE.



NOT TO SCALE

REFERENCE:

(R1) C.R. 15-41, S.J.C.R.

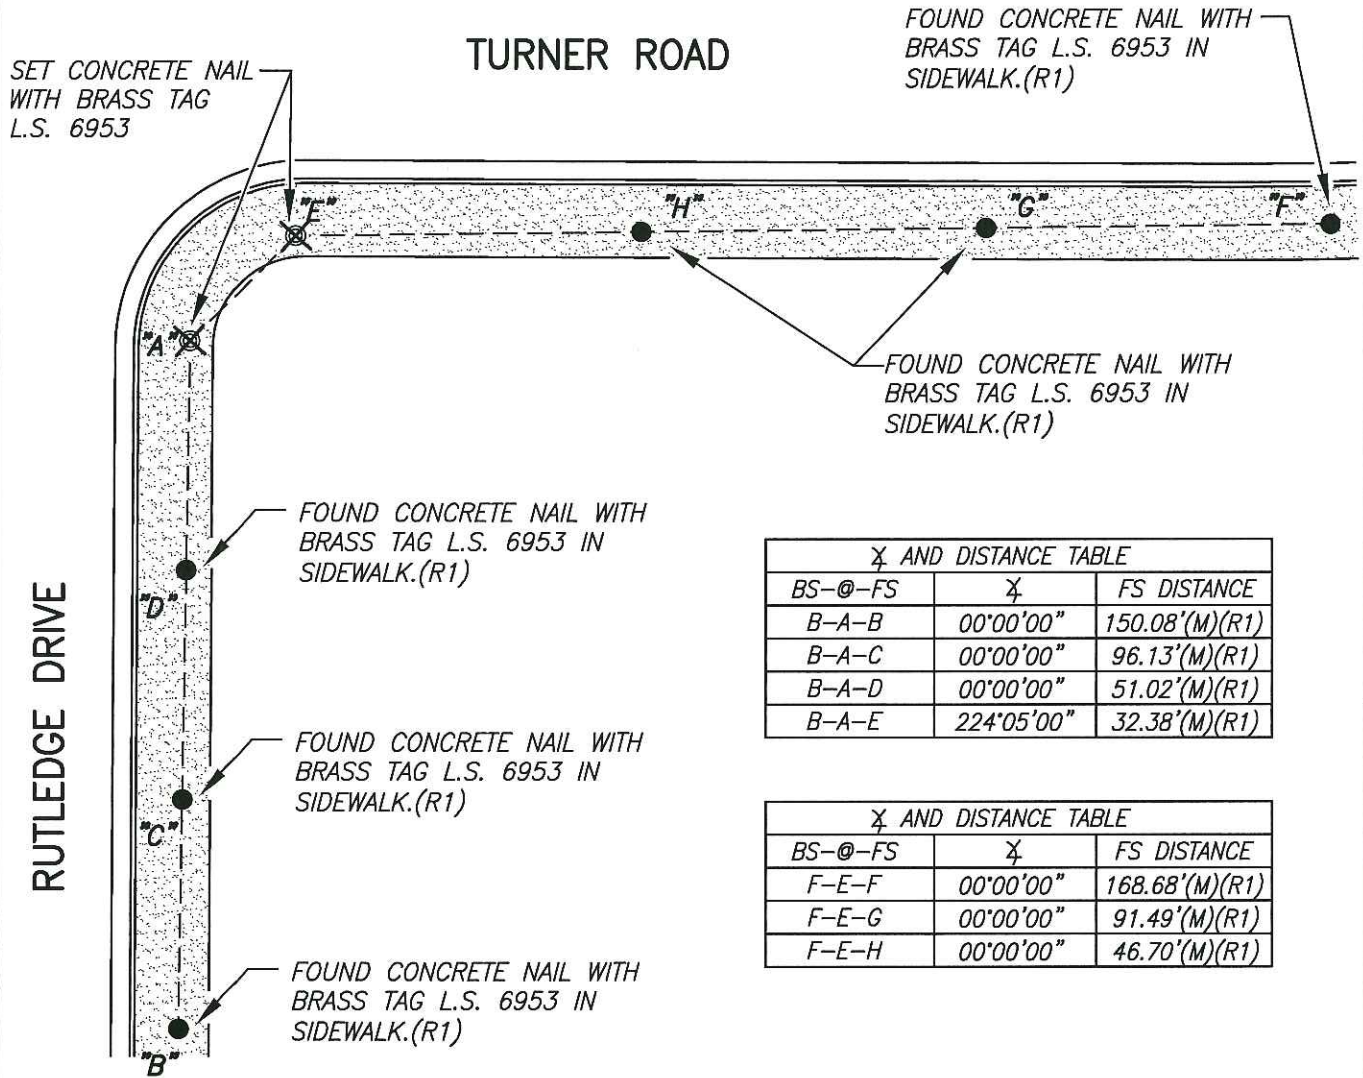

⊗ AND DISTANCE TABLE

BS-@-FS	⊗	FS DISTANCE
B-A-B	00°00'00"	150.08'(M)(R1)
B-A-C	00°00'00"	96.13'(M)(R1)
B-A-D	00°00'00"	51.02'(M)(R1)
B-A-E	224°05'00"	32.38'(M)(R1)

⊗ AND DISTANCE TABLE

BS-@-FS	⊗	FS DISTANCE
F-E-F	00°00'00"	168.68'(M)(R1)
F-E-G	00°00'00"	91.49'(M)(R1)
F-E-H	00°00'00"	46.70'(M)(R1)