CORNER RECORD

			Docume	nt Number	UK-10	
City of	County	of SAN JOA	JOAQUIN , California			
Brief Legal Description	SOUTHWEST CO	RNER OF T	HE 10.94-ACF	RE PROPERT	Y AS SHOWN	ON RS 32-200.
	CC	RNER TYPE			COORDINATE	S(Optional)
18, T15, R9E, MDM	Government Corner Meander Rancho Date of Survey N		perty X	E	och	NAD27 NAD83
10, 112, 123, 1121				Meas. Unit	s: Metric	Imperial 🗵
Corner - Left as found	Found a	nd tagged	Established	Re	established 🗶	Rebuilt
FOUND MONUMENT BE RECORD OF SURVEY, E	300K 32, PAGE 20	0. SEE ATT	ACHED PLAT,	30" LONG.		
WITH A 3/4" IRON PIN C	SURVEYOR'S	STATEMENT			(aco	LAND SILL
This Corner Record was potential the Land Surveyor's Act on Signed	MAY 21	L.S. or R.C.	_, <u>2015</u> . E. No.: LS <u>1</u>60		Exe Strict o	AY C. 12.00.00.7630 - N-3-16
	eived May	22	2015	and examine		
This Corner Beaard was reed			1		J G	
This Corner Record was record and filed June Signed Manager County Title Acting County County Surveyor's Com	SURVETOR	2015 P.L.S. o r R.(-842	- KPROS	WARREN D SMITH NO 4842 FIRE OF CALIFOR



WONG ENGINEERS, INC.

PLANNING ENGINEERING SURVEYING 4578 FEATHER RIVER DRIVE, SUITE A STOCKTON, CALIFORNIA 95219 (209) 476 - 0011

DESCRIPTION:

THIS DOCUMENT IS FOR THE PURPOSE OF RESETTING ANY MISSING OR OBLITERATED CORNERS OF THE SOUTHWEST CORNER OF THE 10.94 ACRE PROPERTY AS SHOWN ON RECORD OF SURVEY BOOK 32, PAGE 200, SAN JOAQUIN COUNTY RECORDS.

NOTE:

THE SECTION / PROPERTY LINE IS BETWEEN SECTION 13, T.1S., R.8E. M.D.B.&M. AND SECTION 18, T.1S., R.9E. M.D.B.&M., SAN JOAQUIN COUNTY.

REFERENCES:

(A) R.S. 32-200

(B) R.S. 36-23

(C) C.R. 14-207

(D) C.R. 12-181

LEGEND:

DENOTES LICENSED L.S.

SURVEYOR

DENOTES IRON 1.

DENOTES FOUND FD.

DENOTES MONUMENT MON.

COR. DENOTES CORNER

DENOTES SECTION SEC.

DENOTES NORTHEASTERLY N.E.


DENOTES PROPERTY PROP.

PAR. DENOTES PARCEL

DENOTES FD MONUMENT OF RECORD UNLESS OTHERWISE STATED

DENOTES SET 3/4' PIN AND CAP L.S. 0

7600

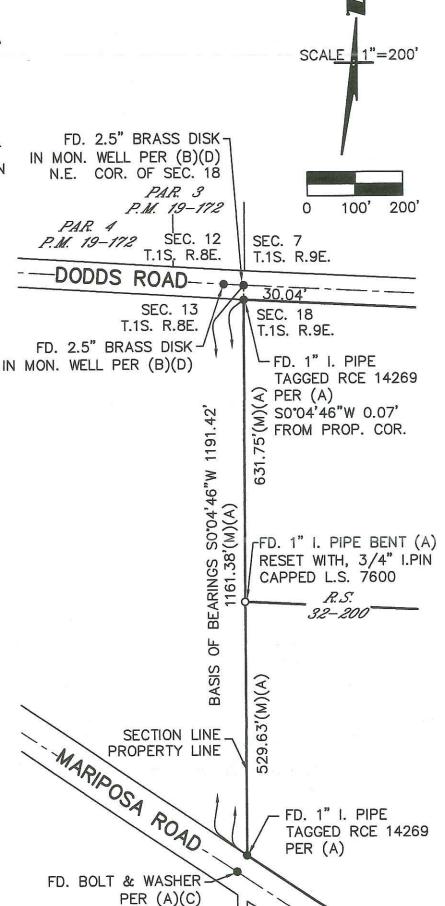

PAGE 2 OF 2