
## **CORNER RECORD**

Document Number
Document Number CR-15-204  County of SAN JOAQUIN , California
OF MACARTHUR DRIVE AND PALMQUIST AVENUE
SECTION 3, T.3S, R.5E, M.D.B.&M.
COORDINATES (Optional)
N
y
NAD83 Epoch
Elev.  Vert. Datum: NVGD29 NVGD88
Meas. Units: Metric 🗌 Imperial 🔀
Established Reestablished Rebuilt
fy or procedure used to establish or reestablish the corne
WELL AT THE INTERSECTION OF MACARTHUR DRIVE
F SECTION 3, T.3S, R.5E, M.D.B.&M.
D AS DOCUMENT NUMBER 14-70 SAN JOAQUIN
TO CONTROL TO THE STATE OF THE
nd and as set or reset:
ES AS SHOWN ON PAGE 2.
LAND
n conformance with
2015 KENT A. Y
2015_, HYSELL \
2015 // HYSFLL \ \
2015 , HYSELL N□, 6953
2015 , HYSELL ND. 6953 mber 6953
mber 6953  T  O15  and examined  WARREN D  SMITH  NO. 4842

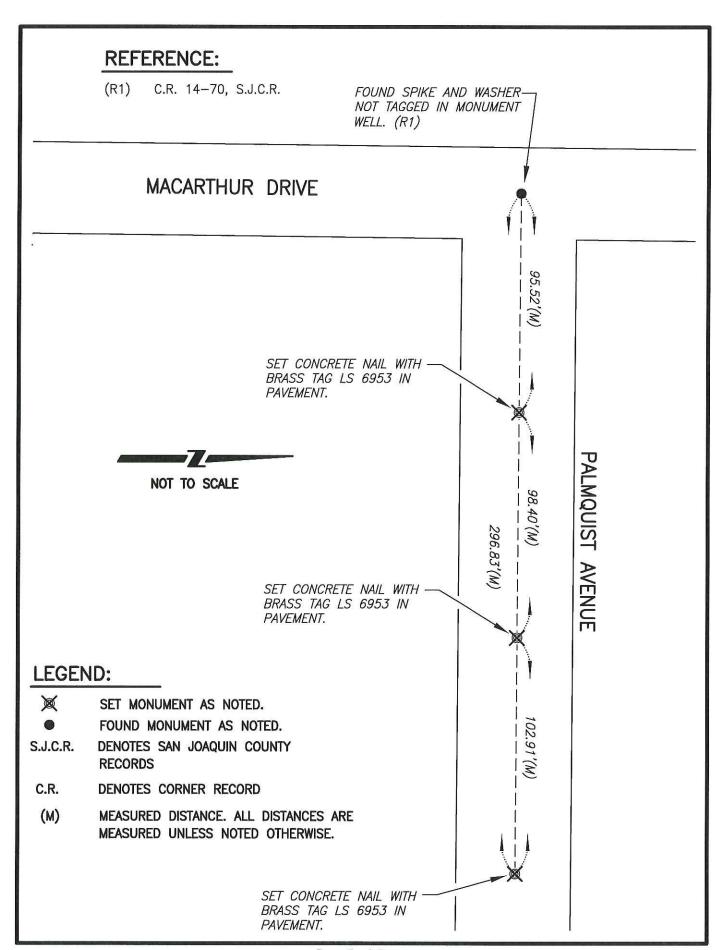

Page 2 of 2