
## **CORNER RECORD**

CORNER	RECORD	Document 1	Vumber	CR-15-205
City of TRA	CY			JOAQUIN , California
Brief Legal Description M		to as property St. Names, 186		
	OCATED ON THE EAST L			200
	CORNER 1	YPE		OORDINATES (Optional)
NW NE	Government Corner	Control		To the state of th
1/4 1/4	Meander	Property	Zone	NAD27 NAD83
SW SE	Rancho	Other 🔀		och
1/4 1/4		0 04 0045	Elev	
SEC. 4 T.3S, R.5E	Date of Survey	8-24-2015	Vert. Datur Meas. Unit	m: NVGD29 NVGD88 s: Metric Imperial
Corner— Left as found	Found and tagged	Established	Reest	tablished Rebuilt
Identification and type of corne	er found: Evidence used	to identify or procedure	used to es	stablish or reestablish the corner:
FOUND 2-1/2" BRASS DIS	SC IN MONUMENT WELL	STAMPED L.S. 5412	AT THE IN	ITERSECTION OF MACARTHUR
DRIVE AND GLENBROOK DI	RIVE. LOCATED ON THE	EAST LINE OF SECTION	ON 4, T.3S	, R.5E, M.D.B.&M.
FOUND MONUMENT AS SHO	OWN ON RECORD MAP	FILED IN BOOK 40 O	F MAPS AN	ND PLATS AT PAGE 4,
SAN JOAQUIN COUNTY REC	CORDS.			
	SURVEYOR'S STATEM	ENT		KENT A.
This Corner Record was prepar	ed by me or under my di	rection in conformance	with	EHST WELL
the Land Surveyors' Act on	AUGUST 25	2015		KENT A. HYSELL
the Lund Surveyors Act on	7,00001 20	,,		ND, 6953
				*
Signed Joanna	P.L.S. or <del>f</del>	R.C.E. Number695	53	OF CALEDRA
CC	DUNTY SURVEYOR'S ST	ATEMENT		CNAL LAND
This Corner Record was receive	ed August 26	ao\sand	l examined	SESSION DE
and filedSeptem				WARREN D SUBJECT OF SMITH NO 4842
Signed Ma D. J.	P.L.S. or	R.C.E. No: 484	2	(0) 1 vg.
Title Acting County S	orveyor			PE OF CALIFORNIA
County Surveyor's Comment			Carrier - Trans	70, 10, and 10
ME COMMINS				

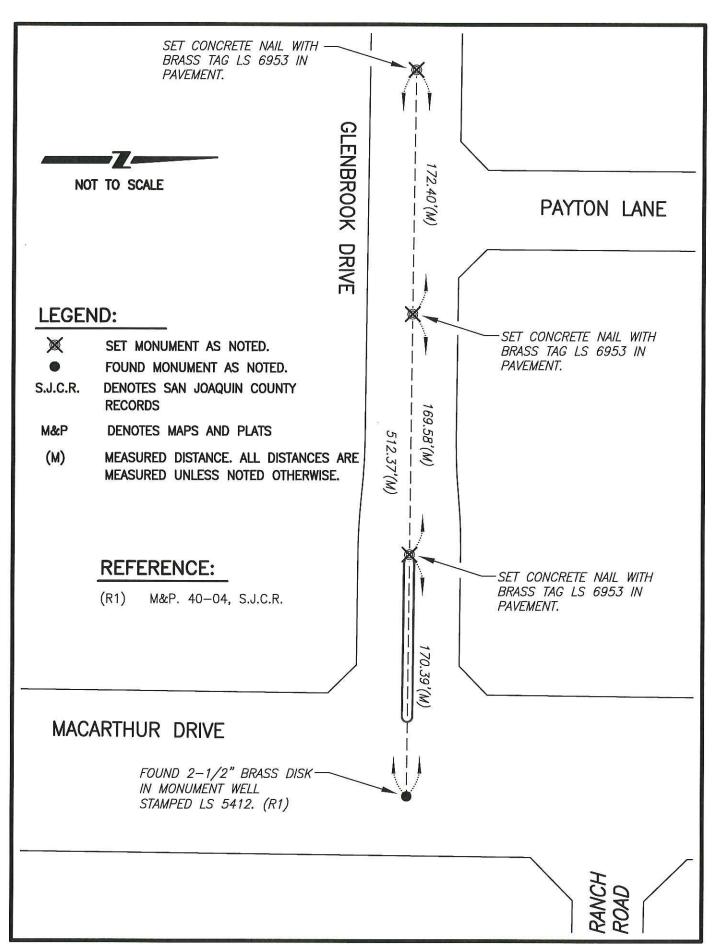

Page 2 of 2