


CORNER RECORD

Document Number CR-15-206
County of SAN JOAQUIN, California

City of TRACY

Brief Legal Description MONUMENT AT THE INTERSECTION OF MACARTHUR DRIVE AND VALPICO ROAD
APPEARS TO BE THE COMMON CORNER BETWEEN SECTIONS 3 AND 4, T.3S, R.5E, M.D.B.&M.

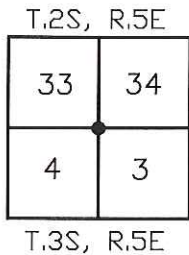

CORNER TYPE

Government Corner Control
 Meander Property
 Rancho Other

Date of Survey 8-24-2015

COORDINATES (Optional)

N _____
 E _____
 Zone _____ NAD27 NAD83
 NAD83 Epoch _____
 Elev. _____
 Vert. Datum: NVGD29 NVGD88
 Meas. Units: Metric Imperial

Corner-- Left as found Found and tagged Established Reestablished Rebuilt

Identification and type of corner found: Evidence used to identify or procedure used to establish or reestablish the corner:
FOUND BOLT AND BRASS WASHER IN MONUMENT WELL AT THE INTERSECTION OF MACARTHUR DRIVE AND
VALPICO ROAD. APPEARS TO BE THE COMMON SECTION CORNER BETWEEN SECTIONS 3 AND 4, T.3S, R.5E,
M.D.B.&M. FOUND MONUMENT AS SHOWN AS SHOWN ON RECORD MAP FILED IN BOOK 33 OF MAPS AND
PLATS AT PAGE 74, SAN JOAQUIN COUNTY RECORDS.

A description of the physical condition of the monument as found and as set or reset: _____
MONUMENT IS IN AN AREA OF RECONSTRUCTION, SET TIES AS SHOWN ON PAGE 2.

SURVEYOR'S STATEMENT

This Corner Record was prepared by me or under my direction in conformance with
 the Land Surveyors' Act on AUGUST 25, 2015,



Signed [Signature] P.L.S. or R.C.E. Number 6953

COUNTY SURVEYOR'S STATEMENT

This Corner Record was received August 26, 2013 and examined
 and filed September 10, 2015




Signed [Signature] P.L.S. or R.C.E. No: 4842

Title Acting County Surveyor

County Surveyor's Comment _____

REFERENCE:

(R1) M&P. 33-74, S.J.C.R.

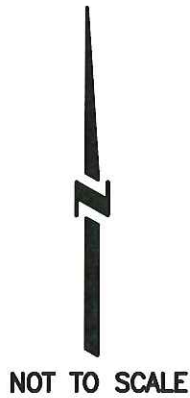

SET CONCRETE NAIL WITH
BRASS TAG LS 6953 IN
PAVEMENT.

SET CONCRETE NAIL WITH
BRASS TAG LS 6953 IN
PAVEMENT.

SET CONCRETE NAIL WITH
BRASS TAG LS 6953 IN
PAVEMENT.

MACARTHUR DRIVE

VALPICO ROAD



FOUND BOLT AND
BRASS WASHER IN
MONUMENT WELL.(R1)

LEGEND:



SET MONUMENT AS NOTED.



FOUND MONUMENT AS NOTED.

S.J.C.R. DENOTES SAN JOAQUIN COUNTY RECORDS

M&P DENOTES MAPS AND PLATS

(M) MEASURED DISTANCE. ALL DISTANCES ARE MEASURED UNLESS NOTED OTHERWISE.