

CORNER RECORD

Document Number CR-15-215
County of SAN JOAQUIN, California

City of ESCALON

Brief Legal Description MONUMENT AT THE SOUTHWEST CORNER OF FIRST STREET AND BAKER AVENUE
LOCATED IN THE NORTHEAST QUARTER OF SECTION 5, T.2S, R.9E, M.D.B.&M.

NW 1/4	NE 1/4 ●
SW 1/4	SE 1/4

CORNER TYPE

Government Corner Control
 Meander Property
 Rancho Other

COORDINATES (Optional)

N _____
 E _____
 Zone _____ NAD27 NAD83
 NAD83 Epoch _____
 Elev. _____
 Vert. Datum: NVGD29 NVGD88
 Meas. Units: Metric Imperial

SEC. 5 T.2S, R.9E Date of Survey 6-17-2015

Corner-- Left as found Found and tagged Established Reestablished Rebuilt

Identification and type of corner found: Evidence used to identify or procedure used to establish or reestablish the corner:
FOUND 3/4" IRON PIPE TAGGED RCE 9924 AT THE SOUTHWEST CORNER OF FIRST STREET AND BAKER
AVENUE. LOCATED IN THE NORTHEAST QUARTER OF SECTION 5, T.2S, R.9E, M.D.B.&M.
FOUND MONUMENT AS SHOWN ON RECORD OF SURVEY FILED IN BOOK 17 OF SURVEYS AT PAGE 55,
SAN JOAQUIN COUNTY RECORDS.

A description of the physical condition of the monument as found and as set or reset: _____
MONUMENT IS IN AN AREA OF RECONSTRUCTION, SET TIES AS SHOWN ON PAGE 2.

SURVEYOR'S STATEMENT

This Corner Record was prepared by me or under my direction in conformance with
 the Land Surveyors' Act on JULY 17, 2015,



Signed [Signature] P.L.S. or R.C.E. Number 6953

COUNTY SURVEYOR'S STATEMENT

This Corner Record was received August 28, 2015 and examined
 and filed September 14, 2015



Signed [Signature] P.L.S. or R.C.E. No: 4842

Title Acting County Surveyor

County Surveyor's Comment _____

LEGEND:

- ⊗ SET MONUMENT AS NOTED.
- FOUND MONUMENT AS NOTED.
- S.J.C.R. DENOTES SAN JOAQUIN COUNTY RECORDS
- R.S. DENOTES RECORD OF SURVEY
- (M) MEASURED DISTANCE. ALL DISTANCES ARE MEASURED UNLESS NOTED OTHERWISE.

REFERENCE:


(R1) R.S. 17-55, S.J.C.R.

FIRST STREET

FOUND 3/4" IRON PIPE
TAGGED RCE 9924. (R1)

SET CONCRETE NAIL WITH
BRASS TAG LS 6953 IN
PAVEMENT.

BAKER AVENUE

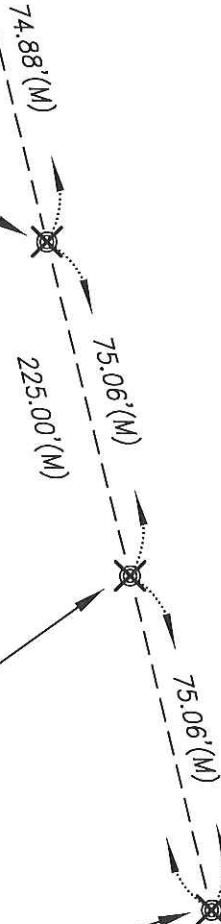

NOT TO SCALE

SET CONCRETE NAIL WITH
BRASS TAG LS 6953 IN
PAVEMENT.

SET CONCRETE NAIL WITH
BRASS TAG LS 6953 IN
PAVEMENT.