

# CORNER RECORD

Document Number CR-15-217  
County of SAN JOAQUIN, California

City of ESCALON

Brief Legal Description FOUND NAIL AT THE INTERSECTION OF FIRST STREET AND GWENDOLYN STREET.  
LOCATED IN THE NORTHEAST QUARTER OF SECTION 5, T.2S, R.9E, M.D.B.&M.

NW 1/4	NE 1/4 ●
SW 1/4	SE 1/4

### CORNER TYPE

Government Corner  Control   
 Meander  Property   
 Rancho  Other

### COORDINATES (Optional)

N \_\_\_\_\_  
 E \_\_\_\_\_  
 Zone \_\_\_\_\_ NAD27  NAD83   
 NAD83 Epoch \_\_\_\_\_  
 Elev. \_\_\_\_\_  
 Vert. Datum: NVGD29  NVGD88   
 Meas. Units: Metric  Imperial

SEC. 5 T.2S, R.9E Date of Survey 6-17-2015

Corner— Left as found  Found and tagged  Established  Reestablished  Rebuilt

Identification and type of corner found: Evidence used to identify or procedure used to establish or reestablish the corner:  
FOUND NAIL AT THE INTERSECTION OF FIRST STREET AND GWENDOLYN STREET. LOCATED IN THE NORTHEAST QUARTER OF SECTION 5, T.2S, R.9E, M.D.B.&M. FOUND MONUMENT AS SHOWN ON PARCEL MAP FILED IN BOOK 13 OF PARCEL MAPS AT PAGE 66A, SAN JOAQUIN COUNTY RECORDS.

A description of the physical condition of the monument as found and as set or reset: \_\_\_\_\_  
MONUMENT IS IN AN AREA OF RECONSTRUCTION, SET TIES AS SHOWN ON PAGE 2.

### SURVEYOR'S STATEMENT

This Corner Record was prepared by me or under my direction in conformance with the Land Surveyors' Act on JULY 17, 2015,



Signed [Signature] P.L.S. or R.C.E. Number 6953

### COUNTY SURVEYOR'S STATEMENT

This Corner Record was received August 28, 2015 and examined and filed September 14, 2015




Signed [Signature] P.L.S. or R.C.E. No: 4842

Title Acting County Surveyor

County Surveyor's Comment \_\_\_\_\_

**LEGEND:**


- ⊗ SET MONUMENT AS NOTED.
- FOUND MONUMENT AS NOTED.
- S.J.C.R. DENOTES SAN JOAQUIN COUNTY RECORDS
- P.M. DENOTES PARCEL MAP
- (M) MEASURED DISTANCE. ALL DISTANCES ARE MEASURED UNLESS NOTED OTHERWISE.

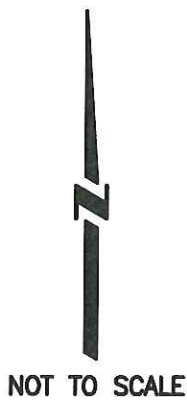

PIONEER STREET

FIRST STREET

GWENDOLYN STREET

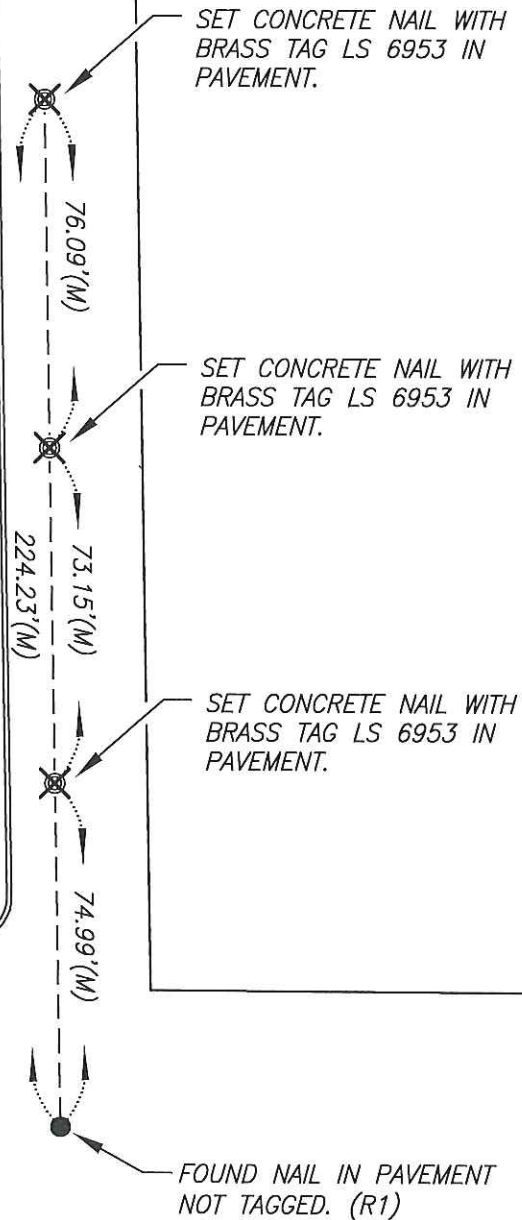

**REFERENCE:**

(R1) P.M. 13-66A, S.J.C.R.