
CORNER RECORD

Document Number CR-15-218 County of SAN JOAQUIN, California **ESCALON** City of Brief Legal Description MONUMENT AT THE SOUTHEAST CORNER OF FIRST STREET AND GWENDOLYN STREET. LOCATED IN THE NORTHEAST QUARTER OF SECTION 5, T.2S, R.9E, M.D.B.&M. COORDINATES (Optional) CORNER TYPE NW Government Corner Control 1/4 X Meander Property SW Rancho Other П NAD83 Epoch____ 1/4 1/4 Elev. Vert. Datum: NVGD29 Date of Survey ____ 6-17-2015 NVGD88 SEC. 5 T.2S, R.9E Imperial X Meas. Units: Metric Found and tagged Established Reestablished Rebuilt Left as found X Corner-Identification and type of corner found: Evidence used to identify or procedure used to establish or reestablish the corner: FOUND 3/4" IRON PIPE AT THE SOUTHEAST CORNER OF FIRST STREET AND GWENDOLYN STREET. LOCATED IN THE NORTHEAST QUARTER OF SECTION 5, T.2S, R.9E, M.D.B.&M. FOUND MONUMENT AS SHOWN ON RECORD OF SURVEY FILED IN BOOK 31 OF SURVEYS AT PAGE 10, SAN JOAQUIN COUNTY RECORDS. A description of the physical condition of the monument as found and as set or reset: MONUMENT IS IN AN AREA OF RECONSTRUCTION, SET TIES AS SHOWN ON PAGE 2. SURVEYOR'S STATEMENT This Corner Record was prepared by me or under my direction in conformance with KENT A. HYSELL the Land Surveyors' Act on _______, ND. 6953 P.L.S. or R.C.E. Number 6953 CSOMAL LAND SUPPLY WARREN D SMITH COUNTY SURVEYOR'S STATEMENT This Corner Record was received August 28, 2015 and examined and filed September 14 2015 No 4842 4842 P.L.S. or R.C.E. No: Title Acting County Surveyor County Surveyor's Comment _____

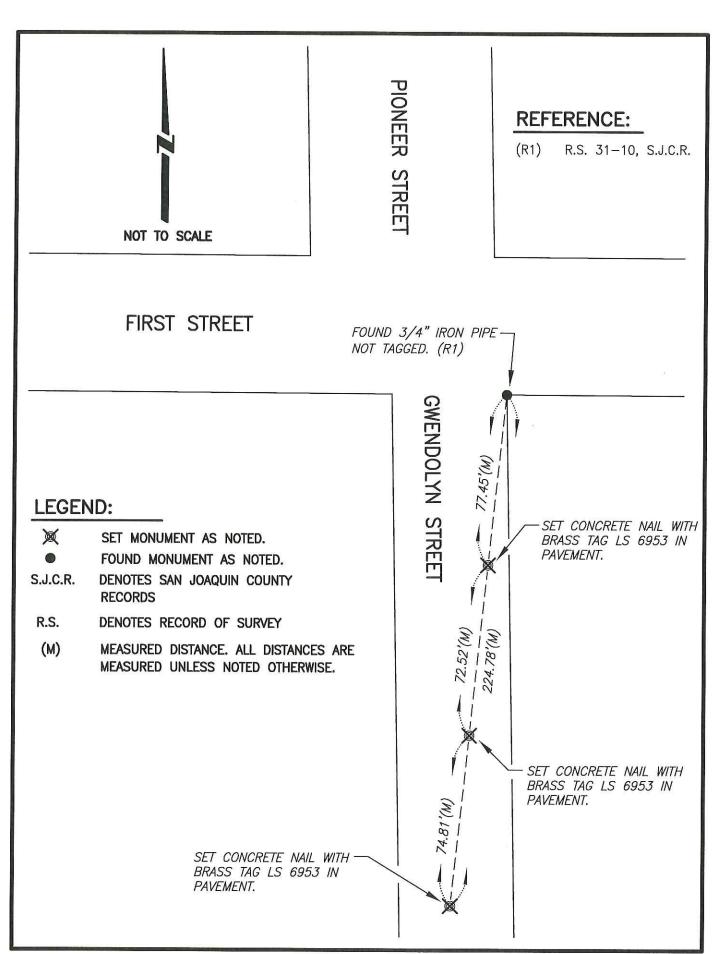

Page 2 of 2