CORNER RECORD

	CKTON					imber		California
J., J.		WESTERLY CORN	IED OE DAE		No. of Contract of	SAN JOAQUIN		
Dilei Legai Des	scription .	WESTERLY CORP	ILITOT FAI	OLL 1, 1 .IVI.	11-30	IN OLO. A., O.IVI.	VVLDLIC	310411
		Government Corner Meander Rancho	Coni Prop Othe	erty 🔀		N E Zone NAD83 Epoch Elev.	NAD27	
Corner - I	_eft as found	Found an	nd tagged	Established		Reestablished	X R	ebuilt 🔲
A description of th	ne physical c	condition of the monun				SEARCHED FOL	JND NOTH	IING, SET
This Corner Rec	ord was pr	SURVEYOR'S S	nder my direc		mance		SENSED LAN	O SURIELION
the Land Surveyo		OCTOBER 22 P. COUNTY SURVEYOR	L.S. or R.C.E				EP 123	13/1
This Corner Reco		ived October	28 015	2015	_ and	l examined	PROPERTY NA	RREN D SMITH OF ABASE



WONG ENGINEERS, INC.

PLANNING ENGINEERING SURVEYING 4578 FEATHER RIVER DRIVE, SUITE A STOCKTON, CALIFORNIA 95219 (209) 476-0011

DESCRIPTION:

THIS DOCUMENT IS FOR THE PURPOSE OF RESETTING ANY MISSING OR OBLITERATED CORNERS FROM THE WESTERLY SIDE OF THE 1.400 ACRE PARCEL AS SHOWN ON PARCEL MAP BOOK 11, PAGE 96, SAN JOAQUIN COUNTY RECORDS.

NOTE:

ALL BEARINGS AND DISTANCES ARE RECORD UNLESS OTHERWISE NOTED.

LEGEND:

L.S. DENOTES LICENSED SURVEYOR

I.PIN DENOTES IRON PIN FD. DENOTES FOUND

P.M. DENOTES PARCEL MAP, BOOK & PAGE

DENOTES MEASURED

DENOTES FD MONUMENT OF RECORD

UNLESS OTHERWISE STATED

(REF. A & B)

DENOTES SET 3/4" I.PIN AND CAP 0


L.S. 7600

REFERENCES:

(A) P.M. 11-96

(B) P.M. 8-59

(C) P.M. 6-190

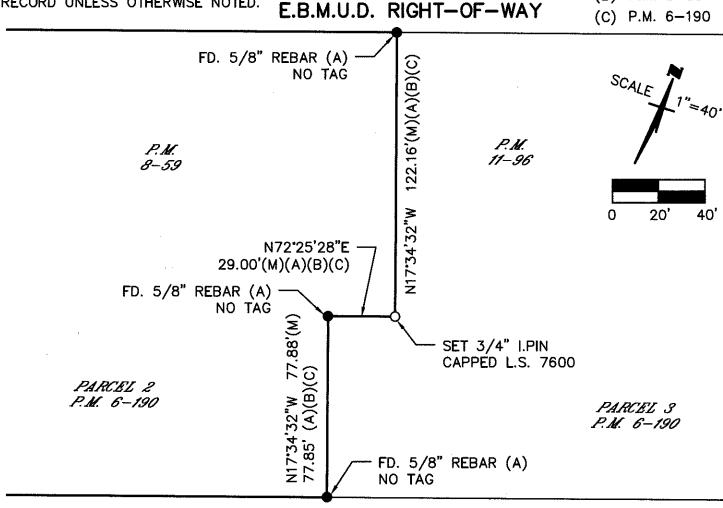

GRAND

CANAL

BLVD.

30,

30,