

CORNER RECORD

Document Number CR-15-288


City of _____

County of SAN JOAQUIN, California

Brief Legal Description EAST 1/4 CORNER OF SECTION 2 OF T3N, R7E

CORNER TYPE

COORDINATES(Optional)

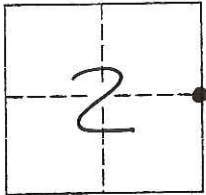

T3N R7E

Government Corner Control
Meander Property
Rancho Other

Date of Survey 10/19/15

N. _____
E. _____
Zone _____ NAD27 NAD83
NAD83 Epoch _____
Elevation _____
Vert. Datum: NGVD29 NAV83
Meas. Units: Metric Imperial

Corner - Left as found Found and tagged Established Reestablished Rebuilt

Identification and type of corner found: Evidence used to identify or procedure used to establish or reestablish the corner:

EXISTING EAST 1/4 CORNER OF SECTION 2 OF T3N, R7E PER RECORD OF SURVEYS VOL. 28, PAGE 146 WAS DESTROYED BY CULVERT REPLACEMENT PROJECT. FOUND 3 REFERENCE POINTS SET PER CORNER RECORD DOCUMENT #06-08. SET NEW MONUMENT USING REFERENCE POINTS ON CORNER RECORD.

A description of the physical condition of the monument as found and as set or reset: SET 2 1/4" DIA. CALIF. DEPT. OF TRANSPORTATION BRASS DISK W/PUNCH MARK IN CENTER IN CONCRETE, DOWN 1.2' INSIDE OF MONUMENT WELL.

SURVEYOR'S STATEMENT

This Corner Record was prepared by me or under my direction in conformance with the Land Surveyor's Act on 11/18, 2015.

Signed [Signature] (P.L.S. or R.C.E. Number 8022)
For the State of California
Department of Transportation




COUNTY SURVEYOR'S STATEMENT

This Corner Record was received November 11, 2015 and examined and filed December 18, 2015.

Signed [Signature] P.L.S. or R.C.E. Number 4842

Title Acting County Surveyor

County Surveyor's Comment _____

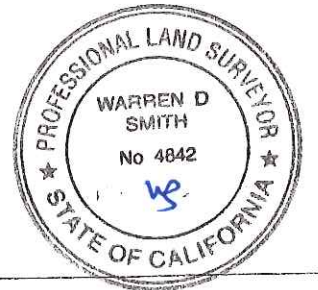



SET 2 1/4" DIA. CALIF. DEPT.
OF TRANSPORTATION BRASS
DISK WITH PUNCH MARK IN
CENTER IN CONCRETE, DOWN
1.2' IN MONUMENT WELL.

← TO LODI

STATE ROUTE 12

TO SEBB →

FOUND PK NAIL
WITH BRASS WASHER
STAMPED "CALTRANS"
IN JOINT USE POLE
PER CR-06-08.

FOUND PK NAIL
WITH BRASS WASHER
STAMPED "CALTRANS"
IN POWER POLE.
PER 06-08.

ALC DRIVEWAY AT
2029 E. STATE ROUTE 12

FOUND PK NAIL
WITH BRASS WASHER
STAMPED "CALTRANS"
IN POWER POLE
PER 06-08.

NOTE: THE TIES SHOWN HEREON ARE FOR THE PURPOSE OF
PERPETUATING AND RE-ESTABLISHING THE
MONUMENTATION CURRENTLY EXISTING. NO
ATTEMPT WAS MADE TO DETERMINE THE VALIDITY
OF THE MONUMENT OR IT'S PROPER LOCATION
IN RELATION TO LEGAL BOUNDARY LINES IN THE AREA.