

CORNER RECORD

DPD-3011 (Rev. 9/97) CT# 7541-4548-0

Document Number CR-16-126

City of _____

County of San Joaquin, California

Brief Legal Description Sec 17 T1N R6E

CORNER TYPE		COORDINATES (Optional)	
Government Corner <input type="checkbox"/>	Control <input checked="" type="checkbox"/>	N. _____	
Meander <input type="checkbox"/>	Property <input type="checkbox"/>	E. _____	
Rancho <input type="checkbox"/>	Other <input type="checkbox"/>	Zone _____ NAD27 <input type="checkbox"/> NAD83 <input type="checkbox"/>	
Date of Survey <u>October 28, 2015</u>		NAD83 Epoch _____	
		Elevation _____	
		Vert. Datum: NGVD29 <input type="checkbox"/> NAVD88 <input type="checkbox"/>	
		Meas. Units: Metric <input type="checkbox"/> Imperial <input checked="" type="checkbox"/>	

Corner - Left as found Found and tagged Established Reestablished Rebuilt

Identification and type of corner found: Evidence used to identify or procedure used to establish or reestablish the corner:
 Found 2-1/4" brass disk stamped "Calif Div of Highways" in concrete on the shoulder of westbound State Route 4.
(State Highway Map dated 10/5/1972, sheet 2 of 6, District 10, S.J.C., Route 4, RM10).

A description of the physical condition of the monument as found and as set or reset:
 Set 2-1/4" brass disk stamped "Calif Dept of Transportation" in a monument well on the shoulder of westbound State Route 4,
 approximately +/- 600 feet west of John Turk Road.


SURVEYOR'S STATEMENT

This Corner Record was prepared by me or under my direction in conformance with
 the Land Surveyors' Act of December 8, 2015
 Signed [Signature] P.L.S. or R.C.E. Number 8415
 For the State of California
 Department of Transportation



COUNTY SURVEYOR'S STATEMENT

This Corner Record was received February 10, 2016 and examined
 and filed February 29, 2016.
 Signed [Signature] P.L.S. or R.C.E. Number 4842
 Title Acting County Surveyor

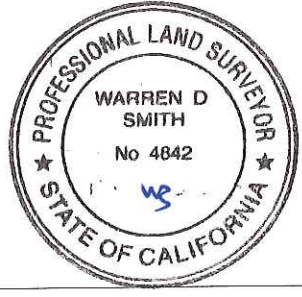

County Surveyor's Comment _____

CORNER RECORD

