CORNER RECORD


					Documer	nt Num	ber	UK-1	6-1	56
City of S	tockton				County of	of San	Joaquin			, California
Brief Legal I	Description	Lincoln Village V	Vest, U	nit No.	23, Book 2	20 of M	aps & Pla	ats, Page	43.	
								0001147	-0/0 /	
	7	CO	RNER TY	PE		- 101		ORDINATE	503 5 0 NEIGO	340
		Government Corner	П	Control	П	N. E.			****	
19		Meander		Property	$\overline{\mathbf{x}}$	Zor	e III		NAD27	NAD83 X
		Rancho		Other	X	NAI	D83 Epoch _	1991.35		
		0	. 1 .	2015	•	Ele	v			
T. 2 N., R. 6 E.	. M D B &M	Date of SurveyO	ctober 8	3, 2015		Ver	t. Datum:	NGVD29		NADV88 X
	, 1,1,1,2,1,2,1,0,1,1,1					Mea	as. Units:	Metric	Ш	Imperial X
Corner -	Left as found	X Found an	ıd tagged		Established		Reestab	lished 🗌	Re	built 🗌
Identification a	nd type of corne	er found: Evidence us	ed to ide	ntify or p	rocedure use	ed to esta	ablish or re	establish t	he corn	er:
Used G.P.S.	to locate cen	terline monumen	ts. Four	nd cut "	'X"s at lot li	ine pro	jections a	and used	total s	tation set
up on cente	rline monum	ents to establish l	ocation	of eacl	n found cut	t "X".				
D = 12.0-2.										
A 1000000000000000000000000000000000000	* Al				1					
200	AND PROCESSOR AND A SECOND CONTRACTOR OF THE S	ondition of the monun				No. Page	1	· 1		
		te, along the appro							-	***************************************
6 feet from I	ot corners. A	lso, found 3/4" iro	on pins	with br	ass tags sta	amped.	R.C.E. 8	189 as sh	own o	n page 2.
										-
										_
		SURVEYOR'S S	TATEME	ENT				//s	NAL L	AND
This Corner	acord was pro	anarad by ma ar un	der my	direction	in conform	ongo wi	th	([5]		1821
This Comer F	kecord was pre	epared by me or un	ider my	airection	i ili conioim	lance wi	uı	11 - 1		BRAINARD (ද්
the Land Surve	eyor's Act on	Octobe	er 20	,_2	015 .					
Signed		6	L.S, or R	C.F. No	,. 70	051		11*/	No.	7051 /*
oigilou			L.O. OF IX					1/3/		12
		OOLINEY OLIDVEYO	D:0 074		-				OF	CALIFORM
	1)	COUNTY SURVEYOR	KS STA	IEMEN					************	-
This Corner Re	ecord was recei	ved <u></u> Februar	y 8	,2	2016	and ex	amined	11	SIGNAL	LANDSU
and filed	Marc	h 24	2016					11.57	1	REN D
	Nn 1		DISAr	RCE I	No.: 41	247		115		4842 S
		9		- (, ∪, ∟, 1	10 <u>-71</u>	0 , _	7	1501	1 1	NO PA
Title Activ	ng County	Surveyor							1	3/38/
County Surv	eyor's Comn	nent						Will state of the	OFC	ALIFO
								-	And the spirit of the last	1 (16, m) part
ilo										

STATEMENT OF PURPOSE:

THE PURPOSE OF THIS SURVEY IS TO IDENTIFY AND RECORD THE LOCATION OF EXISTING MONUMENTS PRIOR TO THE CONSTRUCTION OF PG&E FACILITIES AROUND THE MONUMENTS. THE PURPOSE OF THIS SURVEY IS NOT TO MAKE PROPERTY LINE DETERMINATIONS. LOT LINES SHOWN HEREON ARE FOR GENERAL LOCATION AND INFORMATIONAL PURPOSES ONLY.

LEGEND:

- ⊗ INDICATES FOUND CUT CROSS, NO TAG.
- INDICATES FOUND IRON PINS, 3/4" IN DIAMETER, WITH BRASS TAG ATTACHED STAMPED "R.C.E. 8189" IN CAST IRON MONUMENT WELL.
- O INDICATES SEARCHED FOR RECORD MONUMENT, NOT FOUND

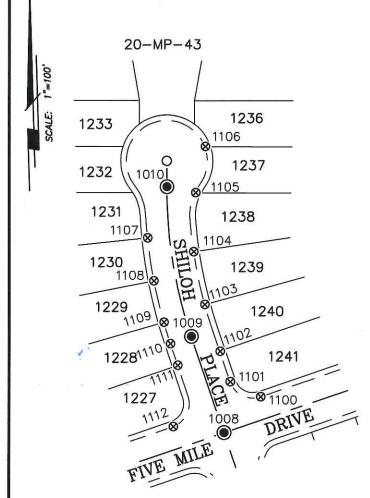

DATUM STATEMENT:

COORDINATES SHOWN HEREON ARE GRID AND ARE BASED ON CITY OF STOCKTON MONUMENTS 7N-3 AND 7N-5, CALIFORNIA COORDINATE SYSTEM (CCS83), ZONE III, 1983 NAD, (1991.35 EPOCH STOCKTON & SAN JOAQUIN COUNTY GPS ADJUSTMENT) AND SHOWN ON RECORD OF SURVEY BOOK 33 OF SURVEYS, PAGE 20. THE PROJECT SPECIFIC SCALE FACTOR IS 0.99993927.

NOTE:

FIELD EFFORT INCLUDED A SEARCH FOR EXISTING CUT CROSSES AT THEIR TYPICAL LOCATION, ONLY THOSE FOUND ARE SHOWN.

GRID	COORDINATES (U.S.	SURVEY FEET)				
POINT	NORTHING	EASTING				
1008	2192145.65'	6313879.98'				
1009	2192249.47'	6313844.66				
1010	2192411.32'	6313818.02				
1100	2192184.38'	6313919.52				
1101	2192200.71	6313886.69'				
1102	2192233.90'	6313875.40				
1103	2192284.01	6313859.19				
1104	2192341.13'	6313847.18				
1105	2192405.06'	6313849.35				
1106	2192455.03'	6313859.72				
1107	2192356.08'	6313796.96				
1108	2192309.55	6313803.87				
1109	2192264.85	6313814.72				
1110	2192241.78'	6313821.97				
1111	2192218.38'	6313829.92'				
1112	2192152.30	6313825.08				