
## CORNER RECORD

Document Number CR-16-172 City of Stockton County of San Joaquin , California Brief Legal Description Southeast corner of Lot 61 per M. & P. 23-74, S.J.C.R. **CORNER TYPE** COORDINATES(Optional) Government Corner Control X Meander Property Zone Rancho Other NAD83 Epoch \_\_\_ Elev. Date of Survey February 29, 2016 Sec. 9, T.2N., R.6E., NGVD29 Vert. Datum: M.D.B. & M. Imperial X Metric Meas. Units: Corner -Left as found Found and tagged Established Reestablished Rebuilt Identification and type of corner found: Evidence used to identify or procedure used to establish or reestablish the corner: See Sheet 2 A description of the physical condition of the monument as found and as set or reset: This is the Pre-Construction Corner Record See Sheet 2 SURVEYOR'S STATEMENT This Corner Record was prepared by me or under my direction in conformance with S. or R.C.E. No.: SESONAL LAND SURPLES WARREN D SMITH **COUNTY SURVEYOR'S STATEMENT** March 24 2016 and examined This Corner Record was received P.L.S. or R.C.E. No.: Title County Surveyor **County Surveyor's Comment** 

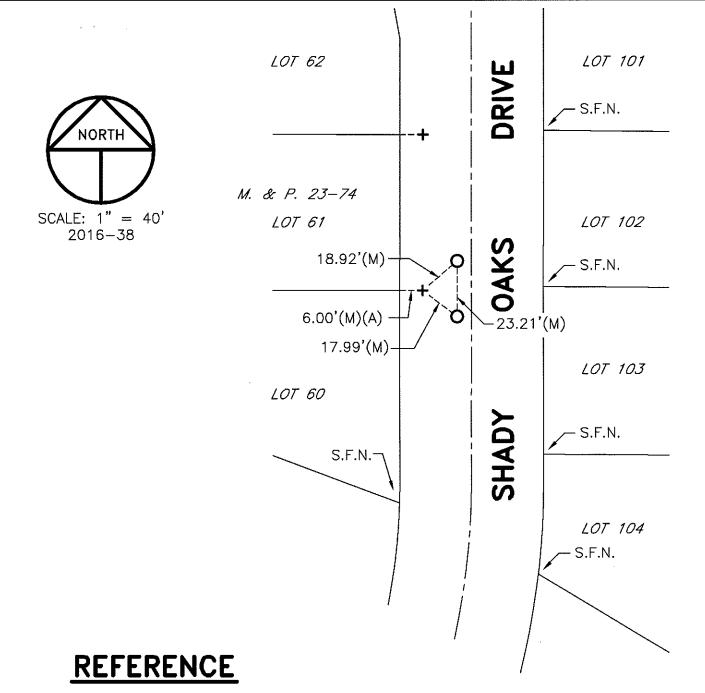

(A) M. & P. 23-74, S.J.C.R.

## **LEGEND**

S.J.C.R. INDICATES SAN JOAQUIN COUNTY RECORD (M) INDICATES MEASURED ON THIS SURVEY S.F.N. INDICATES SEARCHED FOUND NOTHING