
CORNER RECORD

CORNER	RECORD	Document	Number <u>C</u> R	-16-177
City of	MANTECA			QUIN , California
	MONUMENT IN LOUISE AV			
	APPEARS TO BE THE SOUT	TH QUARTER CORNER	OF SECTION 3	30, T.1S, R.7E, M.D.B.&M.
	CORNER 1	TYPE		DINATES (Optional)
NW NE	Government Corner	Control		
1/4 1/4	Meander	Property	Zone	NAD27 NAD83
SW SE	Rancho	Other		
1/4 1/4		7 05 0016	Elev.	uunnaa 🗖 uunnaa 🗖
SEC. 30 T.1S, R.7E	Date of Survey	3-23-2010	Meas. Units:	NVGD29 NVGD88 Metric Imperial X
Corner— Left as four	nd Found and tagged	Established	Reestablis	hed 🔀 Rebuilt 🗌
Identification and type of c	orner found: Evidence used	to identify or procedure	used to establi	sh or reestablish the corner:
	ITH PLASTIC CAP STAMPED			
AVENUE APPROXIMATELY	230'± WEST OF PHILLIPS	S DRIVE APPEARS TO	BE THE SOUT	H QUARTER CORNER OF
	E, M.D.B.&M. FOUND WITNE		OWN ON CORN	ER RECORD FILED AS
DOCUMENT NUMBER CR	-14-309, SAN JOAQUIN (COUNTY RECORDS.		
	SURVEYOR'S STATEM	ENT		KENT A.
This Corner Record was pre	pared by me or under my di	rection in conformance	with	STATE A STATE OF THE STATE OF T
the Land Surveyors' Act on	MARCH 29	. 2016 .		HYSELL HYSELL
Ÿ	100		1	
Signed Y GA	P.L.S. or f	R.C.E. Number 695	53	OF CALEDRA
	COUNTY SURVEYOR'S STA	ATEMENT		ONAL LAND
This Corner Record was rec	eived March 31	and	d examined	WARREN D SUBJECT SMITH
and filed April	12 , 2016			SMITH S
Signed Www D.	P.L.S. or		<u>, </u>	No 4842
Title County Sur	veyor			FIE OF CALIFORN
County Surveyor's Commen				

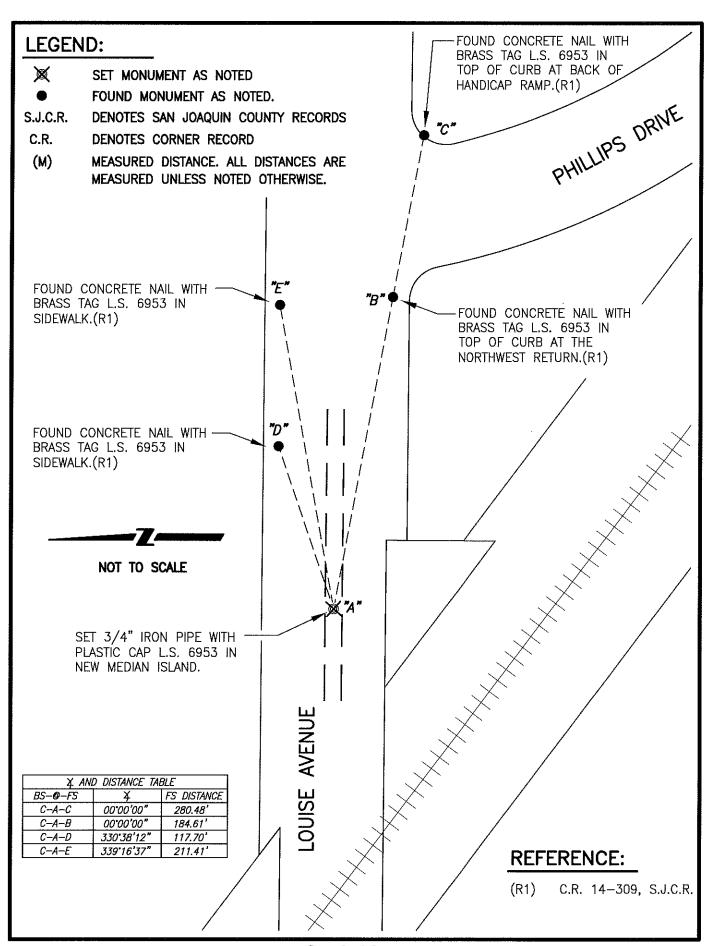

Page 2 of 2