


CORNER RECORD

Document Number CR-16-192

City of _____ County of San Joaquin, California
Brief Legal Description Plat of El Ricado, Volume 6 of Maps & Plats, Page 4.

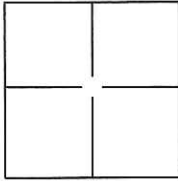

CORNER TYPE

Government Corner Control
Meander Property
Rancho Other

Date of Survey February 4, 2016

COORDINATES(Optional)

N. _____
E. _____
Zone III NAD27 NAD83
NAD83 Epoch 1991.35
Elev. _____
Vert. Datum: NGVD29 NADV88
Meas. Units: Metric Imperial


Corner - Left as found Found and tagged Established Reestablished Rebuilt

Identification and type of corner found: Evidence used to identify or procedure used to establish or reestablish the corner:
Established coordinates on all found monuments by the use of G.P.S. and conventional survey methods. Tied all found monuments to the City of Stockton Horizontal Control System. Evidence identification and field procedure in more detail are shown on page 2.

A description of the physical condition of the monument as found and as set or reset: _____
Found bolt and washer and 1" iron rod with brass tag, tagged "SJCO", as shown on page 2.

SURVEYOR'S STATEMENT

This Corner Record was prepared by me or under my direction in conformance with the Land Surveyor's Act on February 8, 2016.
Signed [Signature] P.L.S. or R.C.E. No.: 7051

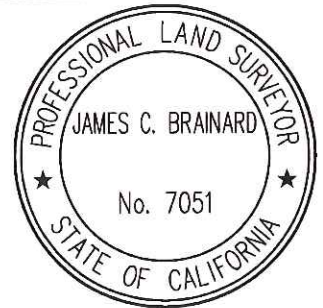

COUNTY SURVEYOR'S STATEMENT

This Corner Record was received March 31, 2016 and examined and filed May 9, 2016.
Signed [Signature] P.L.S. or R.C.E. No.: 4842

Title County Surveyor
County Surveyor's Comment _____



STATEMENT OF PURPOSE:

THE PURPOSE OF THIS SURVEY IS TO IDENTIFY AND RECORD THE LOCATION OF EXISTING MONUMENTS PRIOR TO PG&E IMPROVEMENTS. NO CLAIM IS MADE AS TO THE RELATIONSHIP OF THE MONUMENTS SHOWN HEREON TO THE EXISTING PROPERTY LINES. LOT LINES SHOWN ARE FOR GENERAL LOCATION AND INFORMATIONAL PURPOSES ONLY.



LEGEND:

- INDICATES FOUND MONUMENT AS NOTED
- CHW INDICATES CHAS. H. WIDDOWS
- FB INDICATES FIELD BOOK, BOOK-PAGE

DATUM STATEMENT:

COORDINATES SHOWN HEREON ARE GRID AND ARE BASED ON CITY OF STOCKTON MONUMENTS 6S-TP2 AND 6S-12 CALIFORNIA COORDINATE SYSTEM (CCS83), ZONE III, 1983 NAD, (1991.35 EPOCH STOCKTON & SAN JOAQUIN COUNTY GPS ADJUSTMENT) AND SHOWN ON RECORD OF SURVEY BOOK 35 OF SURVEYS, PAGE 05. THE PROJECT SPECIFIC SCALE FACTOR IS 0.99993620.

GRID COORDINATES (U.S. SURVEY FEET)		
POINT	NORTHING	EASTING
2303	2175257.93'	6346739.22'
2304	2174867.61'	6346858.41'
2305	2175518.07'	6346659.76'

