
CORNER RECORD

Document Number CR-16-219 City of Stockton County of San Joaquin . California Brief Legal Description Southeast corner of Lot 61 per M. & P. 23-74, S.J.C.R. COORDINATES(Optional) **CORNER TYPE** Government Corner Control Zone NAD27 NAD83 X Meander Property Rancho Other NAD83 Epoch Elev. Date of Survey March 23, 2016 NADV88 NGVD29 Sec. 9, T.2N., R.6E., Vert Datum: Imperial X M.D.B. & M. Metric Meas. Units: Left as found Found and tagged Established Reestablished X Rebuilt Corner -Identification and type of corner found: Evidence used to identify or procedure used to establish or reestablish the corner: See Sheet 2 A description of the physical condition of the monument as found and as set or reset: This is the Post-Construction Corner Record See Sheet 2 SURVEYOR'S STATEMENT This Corner Record was prepared by me or under my direction in conformance with the Land Surveyor's Act on S. or R.C.E. No.: L.S. 4450 SSIONAL LAND SURJES WARREN D SMITT **COUNTY SURVEYOR'S STATEMENT** This Corner Record was received ______ May 11 _____, _2016 ____ and examined and filed No 4842 P.L.S. or R.C.E. No.: Title County Surveyor **County Surveyor's Comment**

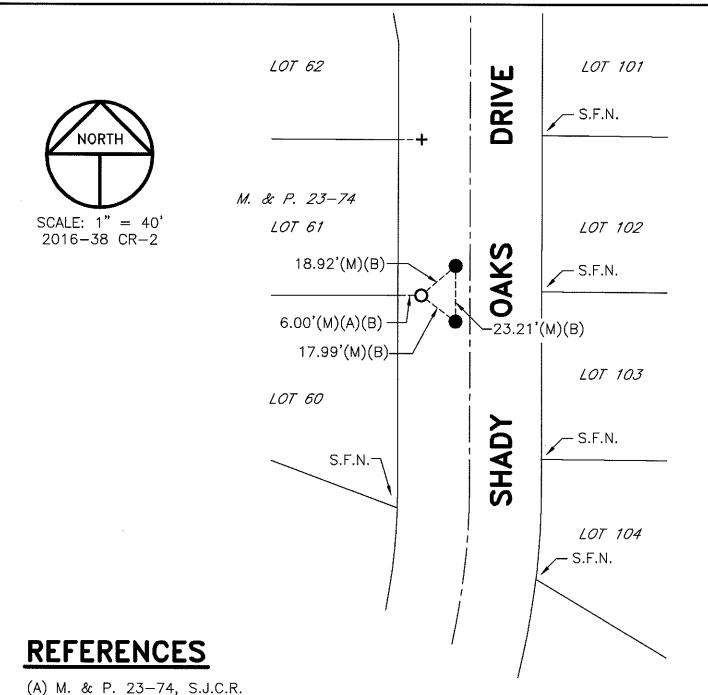

(B) C.R. 16-172, S.J.C.S.R.

LEGEND

INDICATES FOUND MAGNETIC NAIL W/BRASS TAG STAMPED LS 4450 PER (B)

—O— INDICATES SET 1" BRASS DISC STAMPED LS 4450

M. & P. INDICATES MAPS AND PLATS, VOLUME AND PAGE, S.J.C.R.

S.J.C.R. INDICATES SAN JOAQUIN COUNTY RECORDS (M) INDICATES MEASURED ON THIS SURVEY

S.F.N. INDICATES SEARCHED FOUND NOTHING C.R. INDICATES CORNER RECORD, S.J.C.S.R.

S.J.C.S.R. INDICATES SAN JOAQUIN COUNTY SURVEYORS RECORDS