
## **CORNER RECORD**

CORNER	RECURD	, D	ocument N	Number C	R-16-2	21
City of	STOCKTON				AQUIN	
Brief Legal Description	Name of the last o	T THE PROJEC	TED LOT L	INES BETWEE	N LOTS 108	THRU 111
OF CO	DLONIAL ESTATES NORTI	and a contract of the contract	LOCATED			
	CORNE	R TYPE			RDINATES (O	3 112
SEC 8	Government Corner	Control				
320 6	Meander	Property	×		NAD27	
	Rancho	Other		NAD83 Epoch Elev.		2 - 4 - 4 - 4 - 4 - 4 - 4 - 4 - 4 - 4 -
T.2N, R.6E	Date of Survey	3-21-16		ESTAMBLES OF CO.	NVGD29	NVGD88
				Meas. Units:	Metric $\square$	Imperial 🛚
Corner— Left as four	nd 🔀 Found and ta	gged 🗌 Esta	blished 🗌	Reestab	lished 🗌 Re	ebuilt 🗌
Identification and type of c	orner found: Evidence us	sed to identify o	r procedure	used to estab	olish or reestab	lish the corner:
FOUND MONUMENTS AS	SHOWN ON PAGE 2.					
A description of the physica	al condition of the monun	nent as found a	nd as set o	or reset:		
MONUMENTS ARE IN AR	EA OF RECONSTRUCTIO	n, set ties a	S SHOWN	ON PAGE 2.		
		11				
-				u me nemakandan		
	SURVEYOR'S STAT	EMENT			IAN	
This Corner Record was pre	pared by me or under m	v direction in co	onformance v	with	SCHSE	SUPERIN
		201			KENT	/ //
the Land Surveyors' Act on	MARON 23		<u>, , , , , , , , , , , , , , , , , , , </u>		ND, 69	
					* NE. 62	/SS /*/
Signed YbaH	,	55E U 1	605	7	STATE OF CH	IL IF TRANS
Signed	P.L.S. (	or <del>R.C.L.</del> Numbe	r0900	<u> </u>		
	COUNTY SURVEYOR'S	STATEMENT			WARRIE SMI	AND SUC
This Corner Record was rec	eived May 10	, 20	1 <b>6</b> and	examined	WARRE	EN D
and filed Jone Signed	P.L.S.	or R.G.E. No:	4842		OF V	ALIFORNIA .
Title county Suru	eyor				COFO	ALIF
County Surveyor's Comment						
0.000000			.k.			

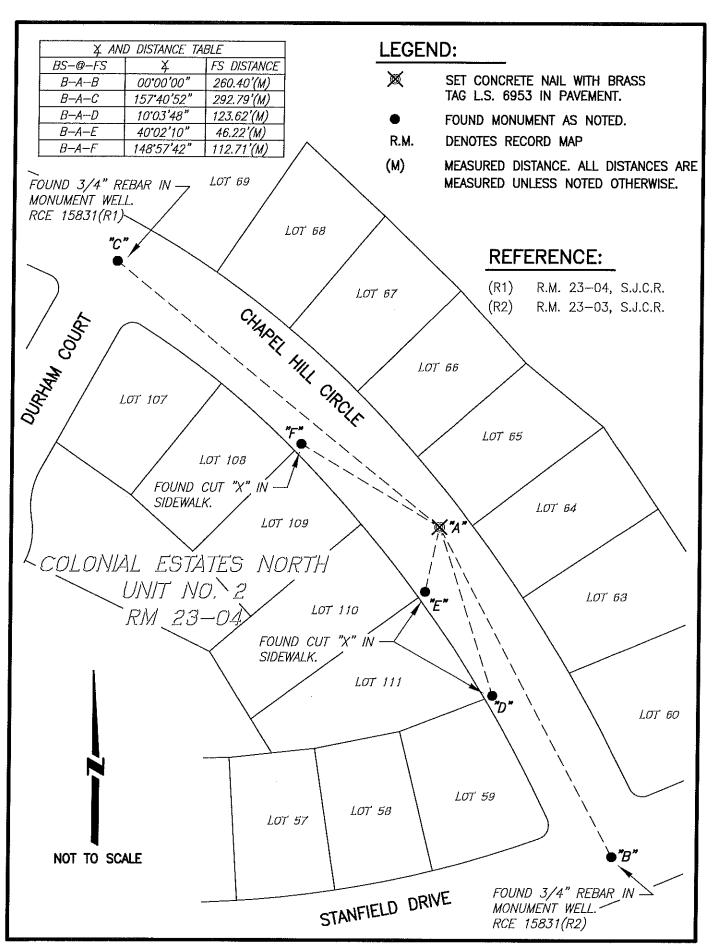

Page 2 of 2