
CORNER RECORD

CORNER	RECORD	Docum	ent Number (CR-16-222
City ofS	TOCKTON	County	of SAN	IOAQUIN , California
Vi	TWO SCRIBED "X" AT THE			
	ESTATES NORTH UNIT NO.			
	CORNER TY	/PE		OORDINATES (Optional)
	Government Corner	Control		
SEC 8	Meander	Property X	Zone	NAD27 NAD83
	Rancho	Other	NAD83 Epo	ch
L DOE	Date of Survey3	-21-16	Part of the second seco	n: NVGD29 NVGD88
T.2N, R.6E	Date of Survey	21 10	- 100 PHOS CO	:: Metric Imperial
Corner— Left as foun	d 🔀 Found and tagged	Established	Reest	ablished Rebuilt
Identification and type of co	rner found: Evidence used to	identify or prod	edure used to est	ablish or reestablish the corner
FOUND MONUMENTS AS				
S	1957			
A description of the physica	I condition of the monument	as found and as	set or reset:	
	*		- West of the second	
	SURVEYOR'S STATEMEN	NT		TAME
TI: O D			!!	KENT A.
This Corner Record was prep	pared by me or under my dire		ance with	// / / //
the Land Surveyors' Act on	MARCH 25	,2016,		HYSELL
				N□, 6953
				SATE TOWN
Signed Jah	P.L.S. or R.C	O.E. Number	6953	OF CALTIES
	COUNTY SURVEYOR'S STAT	TEMENT		WARREN D SHATTER SMITH
This Corner Record was rece	ived May 10	2016	and examined	WARREN D
			• • • • • • • • • • • • • • • • • • • •	SMITH SMITH No. 4842
and filed		<u></u>	242	1 NO 4842
Signed M M A	P.L.S. or	R.C.E. No: 4	842	FITOF CALIFORNIA
Title County Surv	eyor			OF CALIF
County Surveyor's Comment	3			
			0.000	

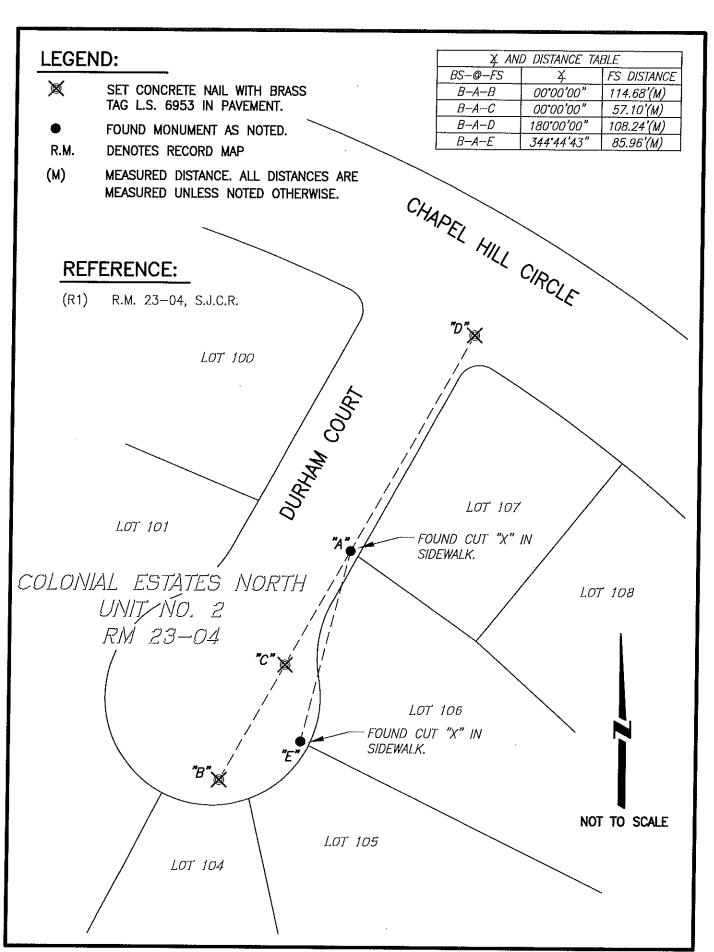

Page 2 of 2