
CORNER RECORD

CORNER RI	ECORD	Doc	ument N	Jumber Ck	2-16-226
City of STOCKT	ON				QUIN , California
Brief Legal Description SCRIB			5		
	NO. 32, LINCOLN V	ILLAGE. LOCAT		ECTION 21, T	.2N, R.6E, M.D.B.&M.
	CORNER	TYPE			RDINATES (Optional)
SEC 21 Gov	ernment Corner 🗌	Control			
Med Med	nder		X		NAD27 NAD83
Rar	cho 🗌	Other			
T.2N, R.6E Date	e of Survey	3-21-16		Vert. Datum:	NVGD29 NVGD88
				Meas. Units:	
Corner— Left as found X	Found and tagge	d 🔲 Establis	hed	Reestablis	shed
Identification and type of corner fo	und: Evidence used	to identify or p	rocedure	used to establi	sh or reestablish the corner
FOUND SCRIBED "X" AT THE F					
LINCOLN VILLAGE FILED IN BO	OK 16 OF MAPS A	ND PLATS AT	PAGE 27	7, SAN JOAQU	IN COUNTY RECORDS.
A description of the physical condi					
MONUMENT IS IN AREA OF RE	CONSTRUCTION, SE	T TIES AS SHO	OWN ON	PAGE 2.	
21	PRVEYOR'S STATEM	CAIT			
					LAND JURES
This Corner Record was prepared b	y me or under my d	irection in confo	ormance 1	with	/ / ハーハ・・・・ / //
the Land Surveyors' Act on	MARCH 25		_1		HYSELL \
				1	★ N□, 6953
1 1.1			W3000000	-	STATE
Signed	P.L.S. or 1	R.C.E. Number _	695	3	OF CALFORN
COUNT	y surveyor's st	ATEMENT			WARREN D SMITH
This Corner Record was received	May 10	, 2016	and	examined	WARREN D
and filed June 9					E SMITH 分分
Signed Man A A	P.L.S. or	-R.C.E . No:	4842		OF CALIFORNIA
Title County Surveyo					FOF CALIFO
County Surveyor's Comment					- September 1
				W. ****	***

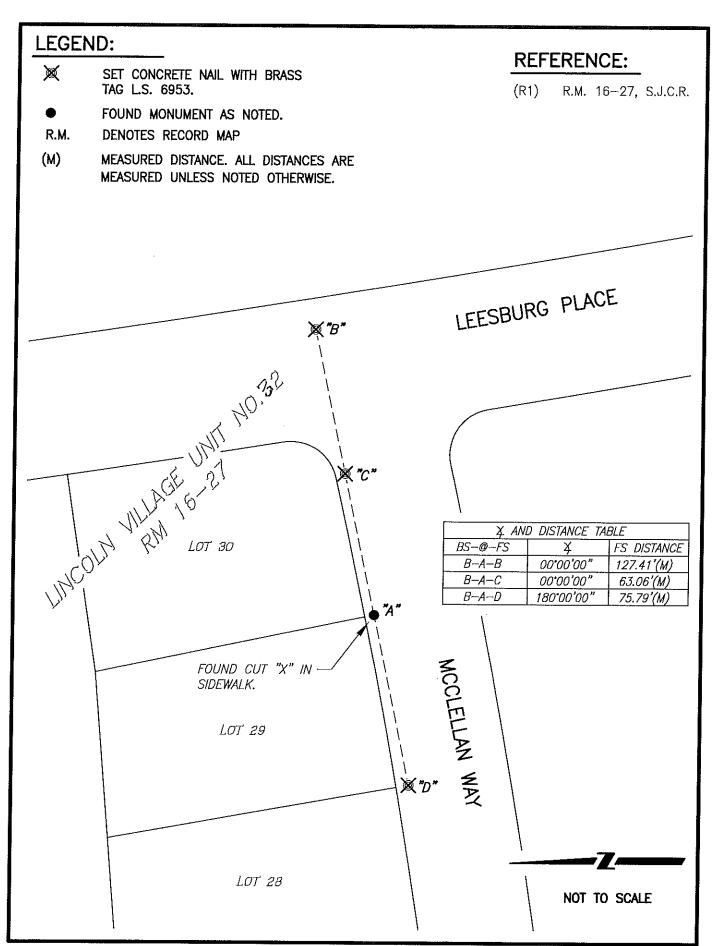

Page 2 of 2