
## **CORNER RECORD**

CORNER	RECORD	Document	Number <u>CR-16-227</u>
City of S	TOCKTON		SAN JOAQUIN , California
			N 17, T.2N, R.6E, M.D.B.&M.
	CORNER T	YPE	COORDINATES (Optional)
	Government Corner	Control	NE
SEC 17	Company Control of the Control of th	Property 🔀	ZoneNAD27
	Rancho	Other	NAD83 Epoch
•	7	27 16	Elev.
T.2N, R.6E	Date of Survey3	1-23-10	Vert. Datum: NVGD29 □ NVGD88 □   Meas. Units: Metric □ Imperial ☒
Corner— Left as foun	d 🔀 Found and tagged	Established	Reestablished Rebuilt
Identification and type of co	rner found: Evidence used t	o identify or procedure	used to establish or reestablish the corne
FOUND SCRIBED "X" AT	THE PROJECTED LOT LINE	BETWEEN LOTS 45	& 46 OF UNIT 1 OF PARK WOODS
FILED IN BOOK 13 OF I	MAPS AND PLATS AT PAGE	164, SAN JOAQUIN	COUNTY RECORDS.
A description of the physica	condition of the monument	as found and as set	or reset:
7.57	OF RECONSTRUCTION, SET		
	8		
		2028	Let
	SURVEYOR'S STATEME	NT	LAND
This Corner Beaard was prop	ared by me or under my dire		with KENT A.
			11 1
the Land Surveyors' Act on _	MARCH 28		( HYSELL )
			N□, 6953 ★
1 /			SATE
Signed Signed	P.L.S. or <del>R.</del>	C.E. Number695	37 OF CALEGREE
	COUNTY SURVEYOR'S STA	TEMENT	examined warren D SMITH
This Corner Record was rece	ived May 10	and	examined WARREN D
and filedJune	9 2016	_	1 4 10 4042
0	P.L.S. or	R.C.E. No: 484-7	PRIE OF CALIFORNIA
Title County Sur	neyor		OFCALI
County Surveyor's Comment			
ete.			

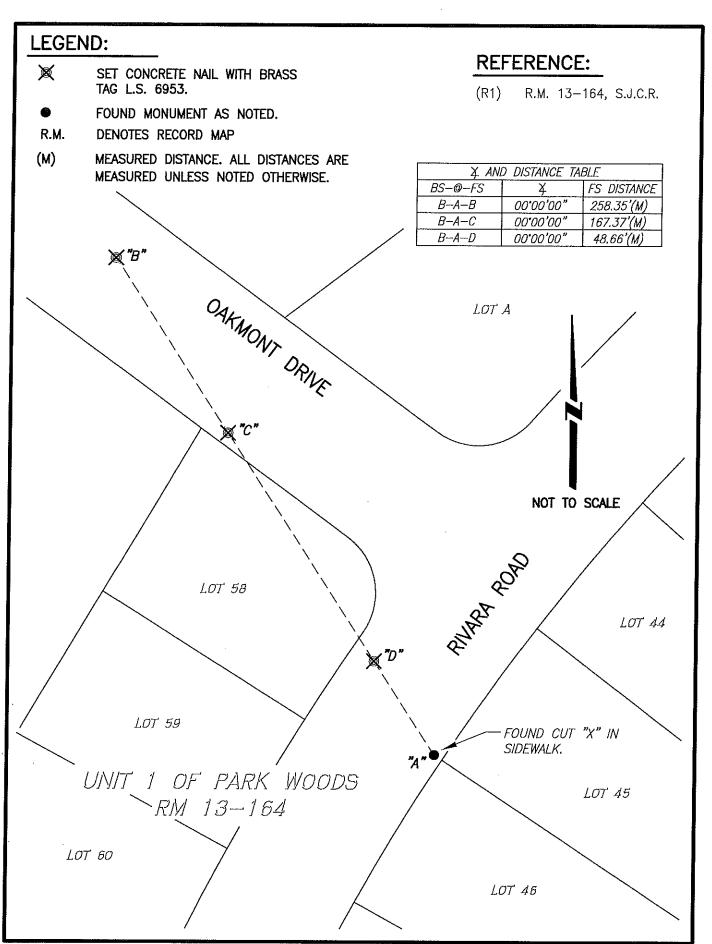

Page 2 of 2