
CORNER RECORD

CORNER RECORD	Document Number CR-16-231
City of STOCKTON	County of SAN JOAQUIN, California
Brief Legal Description SCRIBED "X" AT THE SOUTHERLY	
LOCATED IN SECTION 16 OF THE	C. M. WEBER GRANT.
CORNER TYPE	COORDINATES (Optional)
Government Corner Control	N □ E
SEC 16 Meander Propert	
Rancho 🗌 Other	NAD83 Epoch
C.M. WEBER GRANT Date of Survey	Elev. Vert. Datum: NVGD29 NVGD88
C.M. WEBER GRANT Date of Survey	Meas. Units: Metric Imperial
Corner— Left as found 🛛 Found and tagged 🗌	Established Reestablished Rebuilt
Identification and type of corner found: Evidence used to identi	
FOUND SCRIBED "X" AT THE SOUTHERLY RETURN OF LO	7 378 OF WEBERSTOWN UNIT NO. 5,
FILED IN BOOK 17 OF MAPS AND PLATS AT PAGE 13, S	AN JOAQUIN COUNTY RECORDS.
A description of the physical condition of the monument as four	nd and as set or reset:
MONUMENT IS IN AREA OF RECONSTRUCTION, SET TIES A	S SHOWN ON PAGE 2.
SURVEYOR'S STATEMENT	1 AND CO
This Corner Record was prepared by me or under my direction i	n conformance with
* * * * * * * * * * * * * * * * * * * *	
the Land Surveyors' Act on	2016 , HYSELL NIL 6953)
ii a	★ NE. 8933 ★
Signed P.L.S. or R.C.E. Nu	mber 6953
Signed P.L.S. or R.C.E. Nu	
COUNTY SURVEYOR'S STATEMENT	ZO16 and examined WARREN D SMITH
This Corner Record was received May lo	2016 and examined WARREN D
	SMITH No 4842
and filed June 9 2016 Signed Man D. June P.L.S. or R.C.E. N	1013
Title County Surveyor	No: 4842

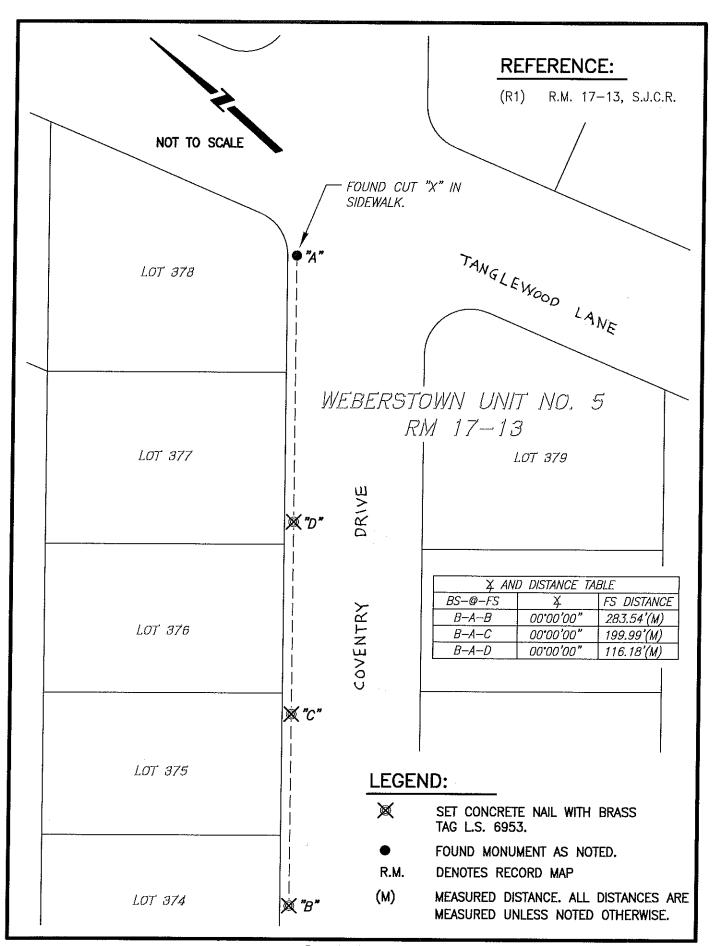

Page 2 of 2