
## **CORNER RECORD**

CORNER RECORD	Document Number CR-16-234
City of STOCKTON	County of <u>SAN JOAQUIN</u> , California
Brief Legal Description SCRIBED "X" AT THE PROJECTED	And the state of t
OF SUPPLIMENTAL ADDITION NO.1 TO FAIR OAKS TRACT.	LOCATED IN SECTION 44, OF THE C.M. WEBER GRANT
CORNER TYPE	COORDINATES (Optional)
Government Corner Contro	N I □ E
SEC 44 Meander Proper	
• Rancho Other	NAD83 Epoch
	Elev.
C.M. WEBER GRANT Date of Survey 3-25-	16   Vert. Datum:   NVGD29   □   NVGD88   □     Meas. Units:   Metric   □   Imperial   ☒
Corner— Left as found 🔀 Found and tagged 🗌	Established Reestablished Rebuilt
Identification and type of corner found: Evidence used to ident	ify or procedure used to establish or reestablish the corner
FOUND SCRIBED "X" AT THE PROJECTED LOT LINE BETW	EEN LOTS 26 & 27 OF BLOCK 24 OF SUPPLIMENTAL
ADDITION NO.1 TO FAIR OAKS TRACT FILED IN BOOK 01	OF MAPS AND PLATS AT PAGE 40, SAN JOAQUIN
COUNTY RECORDS.	
A description of the physical condition of the monument as fou	nd and as set or reset:
MONUMENT IS IN AREA OF RECONSTRUCTION, SET TIES	
SURVEYOR'S STATEMENT	TAND
	in conformance with
This Corner Record was prepared by me or under my direction	<i>II   .</i>
the Land Surveyors' Act onMARCH 28,	2016 , HYSELL
	N□. 6953
	VA TO THE REAL PROPERTY.
Signed P.L.S. or R.C.E. No	umber 6953
COUNTY SURVEYOR'S STATEMEN	2016 and examined warren D SMITH No 4842
This Corner Record was received May lo,	2016 and examined warren D
	and examined
and filed Jone 3, 2016	
and filed June 9, 2016 Signed M. D. J. P.L.S. or R.C.E.	No: 4842
Title County Surveyor	No: 4842
County Surveyor's Comment	

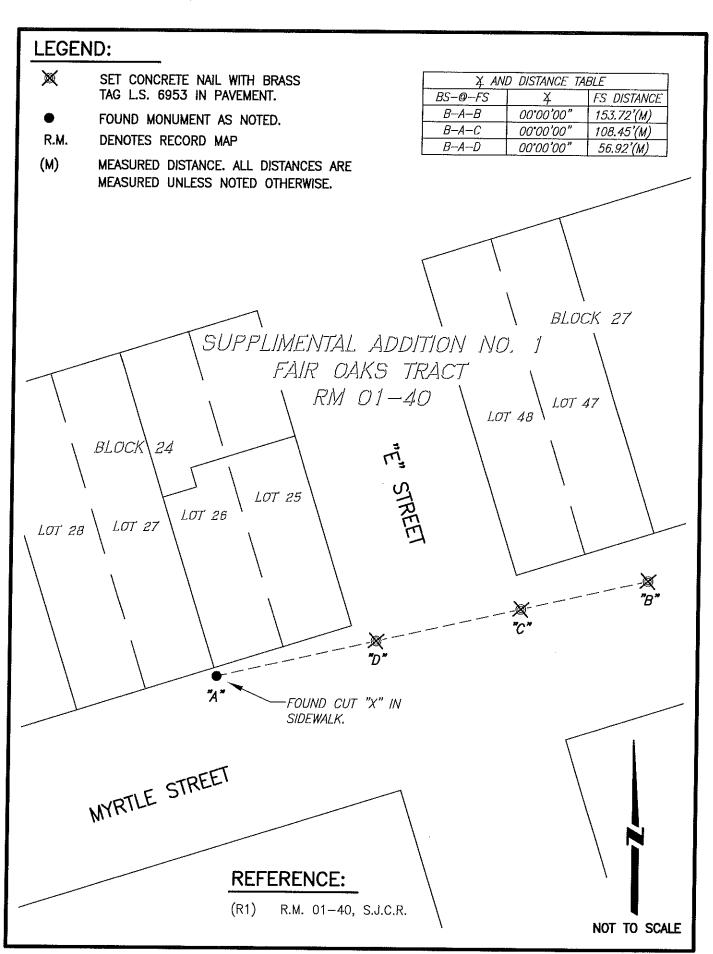

Page 2 of 2