


**CORNER RECORD**

Document Number CR-16-311

City of TRACY

County of SAN JOAQUIN, California

Brief Legal Description FOUND MONUMENT AT THE INTERSECTION OF SCHULTE ROAD AND HANSEN ROAD

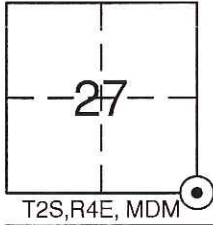

**CORNER TYPE**

Government Corner  Control   
Meander  Property   
Rancho  Other   
Date of Survey MARCH 22, 2016

**COORDINATES (Optional)**

N. \_\_\_\_\_  
E. \_\_\_\_\_  
Zone \_\_\_\_\_ NAD27  NAD83   
NAD83 Epoch \_\_\_\_\_  
Elev. \_\_\_\_\_  
Vert. Datum: NGVD29  NAVD88   
Meas. Units: Metric  Imperial   
U.S. Survey Feet

Corner - Left as found  Found and tagged  Established  Reestablished  Rebuilt

Identification and type of corner found: Evidence used to identify or procedure used to establish or reestablish the corner:  
FOUND 3/4" IRON PIN IN STANDARD MONUMENT WELL, AS SHOWN ON THAT CERTAIN RECORD OF SURVEY FILED FOR  
RECORD DECEMBER 21, 2015, IN BOOK 38 OF SURVEYS AT PAGE 156, SAN JOAQUIN COUNTY RECORDS.  
MON IS THE CORNER TO SECTIONS 27,26,34,35 TOWNSHIP 2 SOUTH, RANGE 4 EAST, MOUNT DIABLO MERIDIAN.

A description of the physical condition of the monument as found and as set or reset: \_\_\_\_\_  
THE MONUMENT WAS FOUND IN GOOD CONDITION. SET CUT CROSSES IN CONCRETE IN PROTECTED LOCATIONS  
TO ALLOW THE STREET MONUMENT TO BE RESET IF DAMAGED OR DESTROYED. AS SHOWN ON SKETCH, PAGE 2.

**SURVEYOR'S STATEMENT**

This Corner Record was prepared by me or under my direction in conformance with  
the Land Surveyor's Act on JUNE 24 2016

Signed Gary K Lamb P.L.S. No. 6627  
GARY K LAMB  
Kier & Wright, Civil Engineers & Surveyors, Inc., Pleasanton, CA



**COUNTY SURVEYOR'S STATEMENT**

This Corner Record was received June 24, 2016  
and examined and filed July 28, 2016

Signed Warren D. Smith P.L.S. or R.C.E. No. 4842  
Title County Surveyor




County Surveyor's Comment \_\_\_\_\_

Z:\2009\A09500-86\Survey\A09500-86 CR-1.dwg 6-24-16 01:52:46 PM glamb

**LEGEND:**

- ⊙ = FOUND MONUMENT AS NOTED
- ⊗ = SET CUT CROSS IN CONCRETE
- = MONUMENT LINE
- = ROW LINE
- - - = TIE LINE
- BD = BRASS DISK
- CR = CORNER RECORD
- MW = MONUMENT WELL
- S = SURVEYS

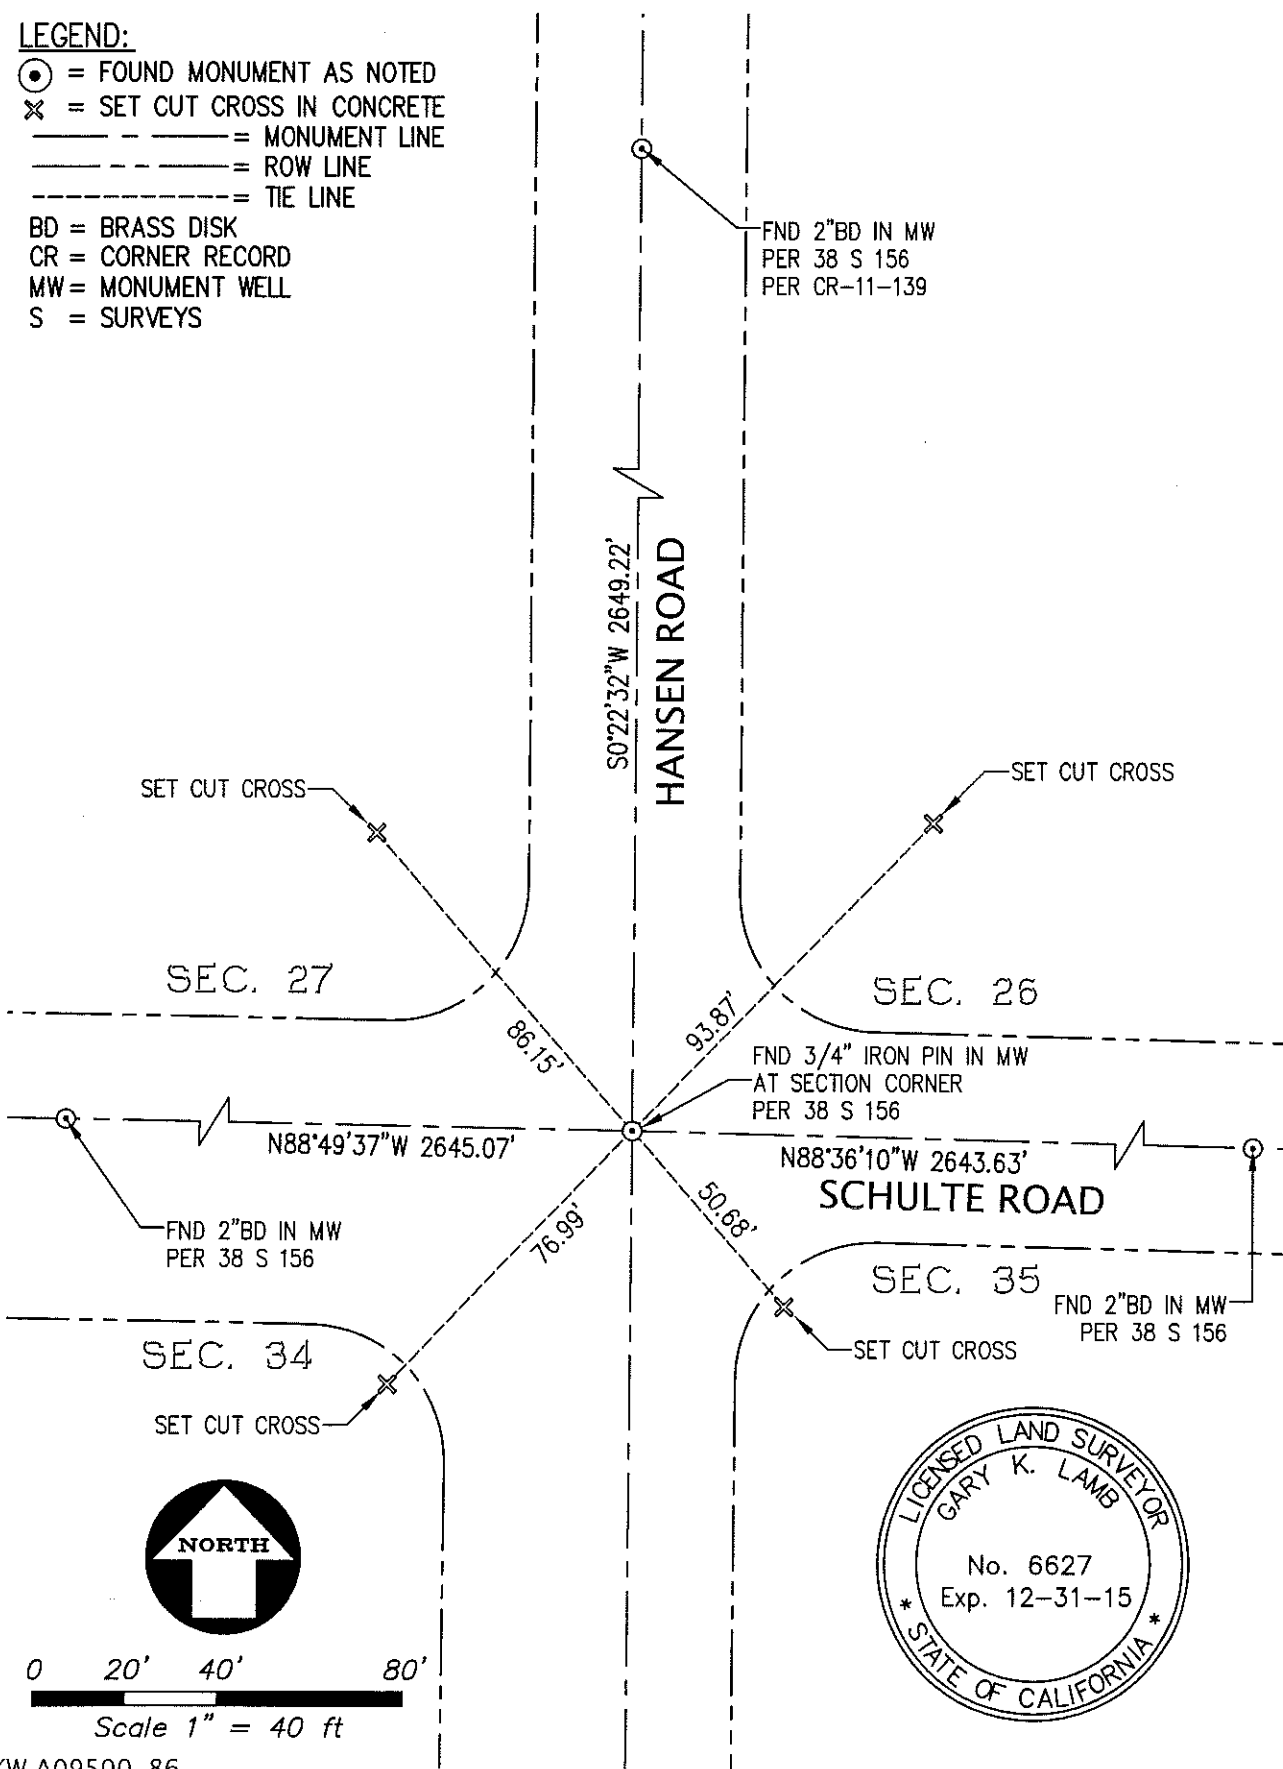

KW A09500-86

Z:\2009\A09500-86\Survey\A09500-86 CR-1.dwg 6-24-16 01:52:46 PM gfarrib