

CORNER RECORD

Document Number CR-16-313

City of TRACY

County of SAN JOAQUIN, California

Brief Legal Description FOUND MONUMENT ON THE CL HANSEN ROAD, 1 MILE +/- NORTH OF SCHULTE ROAD.



CORNER TYPE

Government Corner Control
Meander Property
Rancho Other
Date of Survey MARCH 22, 2016

COORDINATES (Optional)

N. _____
E. _____
Zone _____ NAD27 NAD83
NAD83 Epoch _____
Elev. _____
Vert. Datum: NGVD29 NAVD88
Meas. Units: Metric Imperial
U.S. Survey Feet

Corner - Left as found Found and tagged Established Reestablished Rebuilt

Identification and type of corner found: Evidence used to identify or procedure used to establish or reestablish the corner:
FOUND 2" BRASS DISC WITH PUNCH IN STANDARD MONUMENT WELL, AS SHOWN ON THAT CERTAIN RECORD OF SURVEY FILED FOR RECORD DECEMBER 21, 2015, IN BOOK 38 OF SURVEYS AT PAGE 156, SAN JOAQUIN COUNTY RECORDS. MON IS THE CORNER TO SECTIONS 22,23,27,26 TOWNSHIP 2 SOUTH, RANGE 4 EAST, MOUNT DIABLO BASE & MERIDIAN

A description of the physical condition of the monument as found and as set or reset:
THE MONUMENT WAS FOUND IN GOOD CONDITION. SET MAG NAILS WITH ALUMINUM WASHERS, STAMPED "KIER & WRIGHT CONTROL" AND CUT CROSSES IN CONCRETE IN PROTECTED LOCATIONS TO ALLOW THE STREET MONUMENT TO BE RESET IF DAMAGED OR DESTROYED. AS SHOWN ON SKETCH, PAGE 2.

SURVEYOR'S STATEMENT

This Corner Record was prepared by me or under my direction in conformance with the Land Surveyor's Act on JUNE 24 2016
Signed Gary K Lamb P.L.S. No. 6627
GARY K LAMB
Kier & Wright, Civil Engineers & Surveyors, Inc., Pleasanton, CA



COUNTY SURVEYOR'S STATEMENT

This Corner Record was received June 24, 2016
and examined and filed July 28, 2016
Signed Warren D. Smith P.L.S. or R.C.E. No. 4842
Title County Surveyor




County Surveyor's Comment _____

Z:\2009\A09500-86\Survey\A09500-86 CR-3.dwg 6-24-16 01:53:14 PM glamb

LEGEND:

- ⊙ = FOUND MONUMENT AS NOTED
- ⊗ = SET CUT CROSS IN CONCRETE
- ⊗ = SET MAG NAIL & ALUMINUM WASHER STAMPED "KIER & WRIGHT CONTROL"
- = MONUMENT LINE
- = ROW LINE
- = TIE LINE
- BD = BRASS DISK
- CR = CORNER RECORD
- MW = MONUMENT WELL
- S = SURVEYS

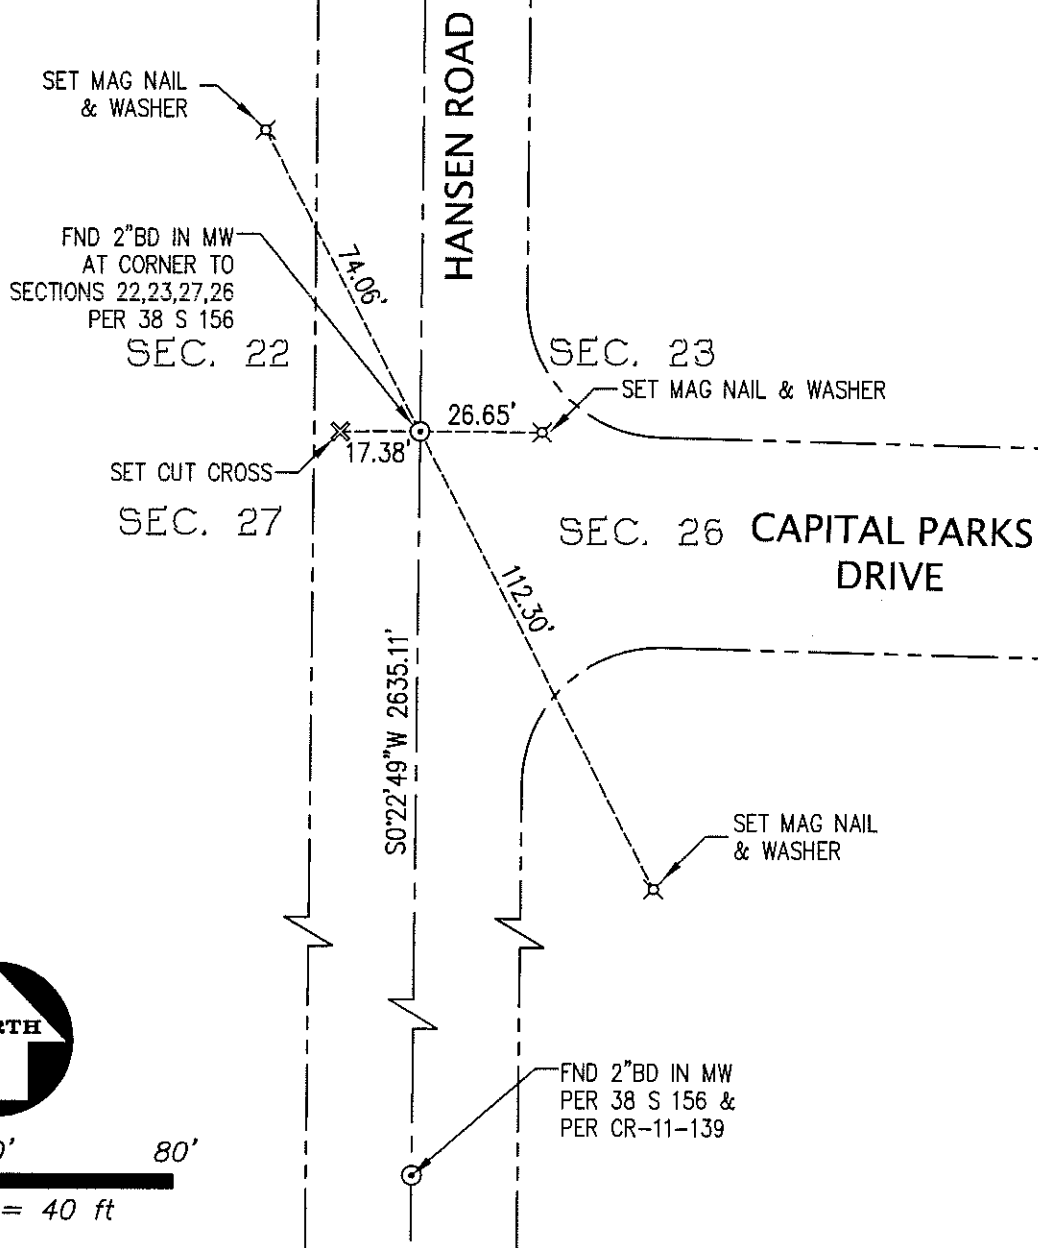

KW A09500-86

Z:\2009\A09500-86\Survey\A09500-86 CR-3.dwg 6-24-16 01:53:15 PM glamb