CORNER RECORD

CORNE	RRECORD	Document Numb	er CR-16-317
City of Manteca		County of	San Joaquin , California
Brief Legal Description	Northgate, Unit No. 6, Boo	k of Maps & Plats Vo	l. 19, Page 91.
	CORNER TYPE	2000	COORDINATES(Optional)
29	Government Corner Control Meander Prope Rancho Other	rol	a III NAD27 NAD83 X 83 Epoch 1991.35
T. 1 S., R. 7 E., M.D.B.&M.	Date of Survey April 28, 20		Datum: NGVD29 NADV88 S. Units: Metric Imperial X
Corner - Left as found	∃ X Found and tagged □	Established	Reestablished Rebuilt
identification and field p	condition of the monument as found	own on page 2.	on on found cut crosses. Evidence
Found 3/4" fron pins, in	monument wells and found co	it crosses in concrete	as snown on page 2.
			9
This Corner Record was puthe Land Surveyor's Act on Signed	SURVEYOR'S STATEMENT orepared by me or under my direct May 11, P.L.S. or R.C.E. COUNTY SURVEYOR'S STATEMENT	2016 . No.: 7051	No. 7051 ** ** ** ** ** ** ** ** **
This Corner Record was record and filed Signed Title County Surveyor's Com	28 , 2016 . P.L.S. or R.G.	E. No.: 4842	warren D SMITH No 4842 PAR CALIFORNIA
S			
-			

STATEMENT OF PURPOSE:

THE PURPOSE OF THIS SURVEY IS TO IDENTIFY AND RECORD THE LOCATION OF EXISTING MONUMENTS PRIOR TO PG&E IMPROVEMENTS. NO CLAIM IS MADE AS TO THE RELATIONSHIP OF THE MONUMENTS SHOWN HEREON TO THE EXISTING PROPERTY LINES. ORIGINAL LOT LINES SHOWN ARE FOR GENERAL LOCATION AND INFORMATIONAL PURPOSES ONLY.


LEGEND:

- INDICATES FOUND 3/4" IRON PIN, NO TAG, IN MONUMENT WELL, UNLESS OTHERWISE NOTED



COORDINATES SHOWN HEREON ARE GRID AND ARE BASED ON THE RECORD OF SURVEY OF EXISTING SECTION CORNER MONUMENTATION IN THE CITY OF MANTECA, CALIFORNIA COORDINATE SYSTEM (CCS83), ZONE III, 1983 NAD, (1991.35 GPS ADJUSTMENT) AS SHOWN ON RECORD OF SURVEY BOOK 33 OF SURVEYS, PAGE 133. THE PROJECT SPECIFIC SCALE FACTOR IS 0.99998309.

GRID COORDINATES (U.S. SURVEY FEET)			
POINT	NORTHING	EASTING	
1	2122768.38*	6352195.15	
2	2121988.32'	6352201.94'	
3	2122766.92	6352425.15	
4	2122769.72	6351965.40'	
500	2122671.95'	6352174.01	
501	2122613.95'	6352174.51	
509	2122553.05'	6352219.04	
510	2122669.09'	6352218.01	
511	2122745.71	6352312.12'	

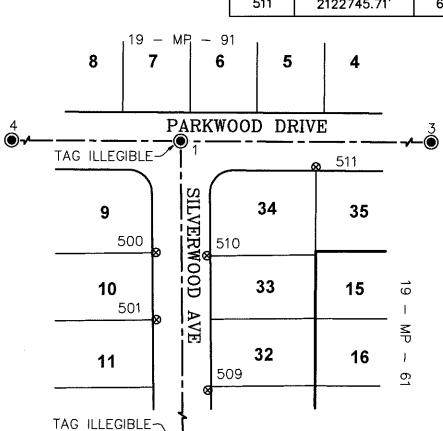

S: \6666\181 Parkwood — Silverwood (Manteca)\10 — CAD Drawings\Silverwood 1.dwg