
CORNER RECORD			Document Number <u>CR-16-368</u>			
City of		Cou	unty of S	an Joaquin,	California	
Brief Legal DescriptionBLO	SSOM ROAD 2600' ± SOUTH OF BARBE	r road			27	
32 Mer Rar T5N R5E Dat	CORNER TYPE vernment Corner ⊠ Control □ ander □ Property □ acho □ Other □ e of SurveyJuly 14, 2016	*	N E Zone		□ NAD83 □	
MDB&M Corner - Left as found	↑ Found and tagged ☐ Established	ed 🛚	Reestablishe	d □ Reb	uilt 🗆	
A description of the physical SEE SKETCH ON BACKSIDE.	condition of the monument as found o	and as se	et or reset:			
This Corner Record was prepared the Land Surveyors' Act or	VEYOR'S STATEMENT ared by me or under my direction in continuous direction di		/	SONAL SONAL SONAL	LAND SUBJECTION OF THE PROPERTY OF THE PROPERT	
COUNT	P.L.S. Number 865 Y SURVEYOR'S STATEMENT ceived July 25, 2016 c 19, 2016. P.L.S. No.	and exa	ımined		ENSE 8657 *	
Title County Survey County Surveyor's Comme	or				LAND SUBJETION THE HARALE HARA	
(D.D. Sheet No. 79) (Job No. 320487)				E OF	TATIFOX	

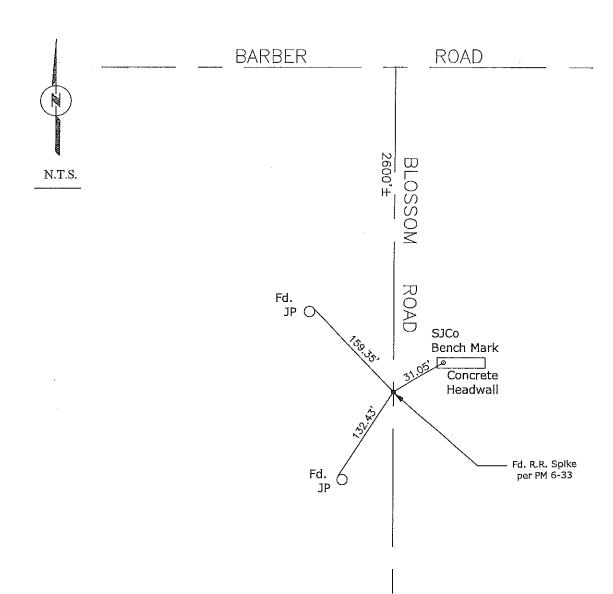

Note: Found Monuments are not tagged unless otherwise noted.

"No Attempt Was Made to Verify the Monument(s)"

Set=Conc. Nail with Brass Washer Stamped
"S.J. Co.", unless otherwise noted
Fd.=Found Conc. Nail with Brass Washer Stamped
"S.J. Co.", unless otherwise noted
CR=Corner Record
FP=Fence Post
JP=Joint Pole
LP=Light Pole
PP=Power Pole
GP=Guy Pole
SP=Service Pole
TP=Telephone Pole
S.F.N.=Seorched Found Nothing
N.T.S.=Not To Scale
M&P=Maps & Plats
PM=Parcel Map
RS=Record of Survey
FB=Field Book