
CORNER RECORD Electronic File Number Document Number CR-110-443

		Docur	nent Num	ber OKTO	917				
City of	MANTECA	Count	y of	SAN JOAQUIN		, Califori	nia		
Brief Legal Des	scription BEING THE RE-ESTABLISMENT O	F THE CENTER LINE	:/CENTERLIN	NE INTERSECTION OF	MAIN ST. AT T	ANNEHILL DI	₹.,		
LYING WITHIN THE	E SW. 1/4 OF SEC. 9, T. 2S., R. 7 E., M.D.M. A	S SHOWN IN BOOK	35 OF MAPS	& PLATS AT PAGE 3	1, S.J.C.R.				
	1 CORNER	TYPE		COORDIN	ATES(Option	nnal)			
8 9	Government Corner	Control Property		N E					
17 16	Rancho	Other		Zone NAD83 Epoch Elev		50			
Section <u>9</u> T. <u>2S.</u> , R. 7E.	Date of Survey <u>SEPT</u>	EMBER 16, 2016		Vert. Datum: Meas. Units:					
Corner - Le	eft as found 🗆 Found and To	ıgged □ Esto	ablished [Reestablishe	d 🗷 Rebi	uilt 🗆			
dentification and type of corner found: Evidence used to identify or procedure used to establish or reestablish the corner: MONUMENT REPLACED PURSUANT TO MAP OF MISSION GARDENS UNIT NO. 1, BK. 35 M.P., PG. 31, S.J.C.R. SAID MONUMENT WAS OMITTED INADVERTENTLY UPON COMPLETION OF CONSTRUCTION OF THE SUBDIVISION. SET MONUMENT UTILIZING EXISTING FOUND MONUMENTS ON SECTION LINE AS ILLUSTRATED ON SAID									
MISSION GARDENS UNIT NO. 1 SUBD. WITH TIES TO THE C/L MON. AT THE B.C. ON TANNEHILL DR.									
A description of the physical condition of the monument as found and as set or reset: SET 3/4" INSIDE DIAMETER IRON PIPE WITH PLASTIC PLUG STAMPED L.S. 7126 IN PAVEMENT									
FLUSH WITH TOP OF PAVEMENT AS INDICATED ON SHEET 2 OF 2									
							_		
and Surveyor's	STATEMENT ecord was prepared by me or un s Act on SEPTEMBER 20 P.L VEYOR'S STATEMENT	, 2016 .	ion in cor	nformance with	D.L. SKIDM	HORE 90	100		
This Corner Reand filed Signed AV A Title County	December 9 2016	ber 26, E. No.: 484	20	and examined	WARRIED NO 4	3	- 11		

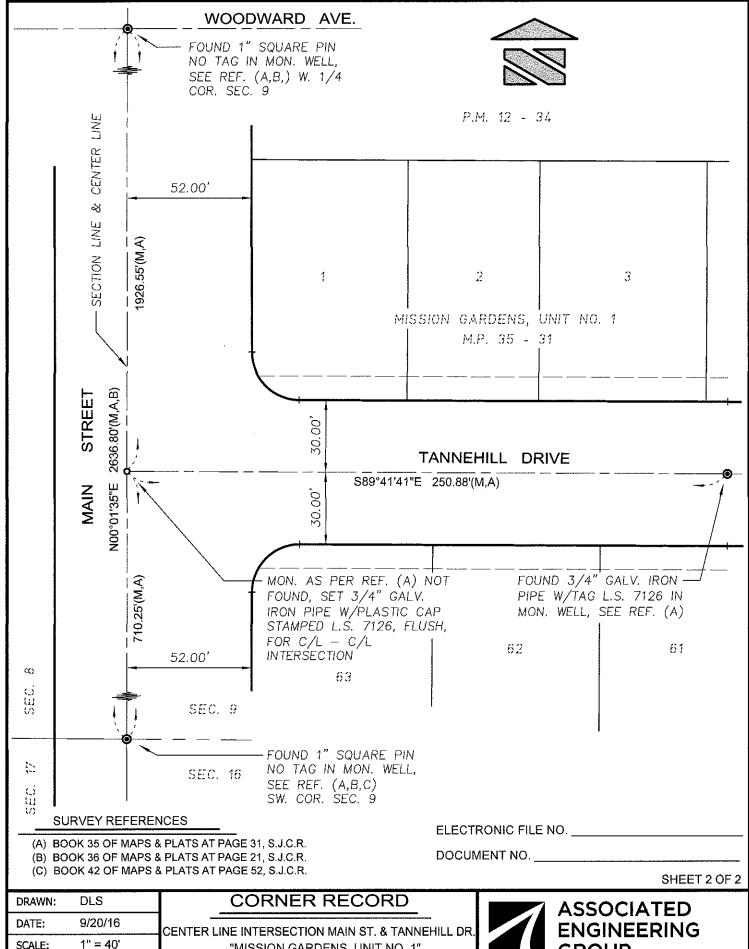

	•	
DATE:	9/20/16	CENTER LINE INTERSE
SCALE:	1" = 40'	"MISSION (
JOB #:	1123-16	BK. 35, MAPS
DWG:	CR MG1	COUNTY OF SAN IO

GARDENS, UNIT NO. 1", & PLATS, PG. 31, S.J.C.R.

Y OF MANTECA COUNTY OF SAN JOAQUIN, STATE OF CALIFORNIA



4206 TECHNOLOGY DRIVE, SUITE 4, MODESTO, CA 95356 PHONE: (209) 545-3390 FAX: (209) 545-3875 www.assoceng.com