
## **CORNER RECORD**

CORNE	RECURD	Document	Number <u>CR-/</u>	7-23
City of	STOCKTON	County of	SAN JOAQUIN	, California
Brief Legal Description	MONUMENT AT THE PROJ			
OF C	COLONIAL ESTATES NORTH U	<u>NIT NO. 2. LOCATE</u>	D IN SECTION 8, 1.2N,	R.be, M.D.B.&M.
	CORNER		COORDINATES	S (Optional)
	0	Control	N	
SEC 8	Government Corner   Meander	Property X	EN	NAD27 NAD83 🔀
	Rancho	Other	NAD83 Epoch	
			Elev.	
T.2N, R.6E	Date of Survey	11-04-16	Vert. Datum: NVGD29 Meas. Units: Metric	
Corner— Left as fo	und 🗌 Found and tagge	d 🗌 Established [	Reestablished 🔀	Rebuilt
Identification and type of	corner found: Evidence used	to identify or proced	ure used to establish or re	eestablish the corner:
SET CONCRETE NAIL \	WITH BRASS TAG STAMPED	LS 6953 AT THE P	ROJECTED LOT LINE BET	WEEN LOTS
108 & 109 OF COLO	NIAL ESTATES NORTH UNIT	NO. 2. FOUND WITH	NESS CORNERS AS SHO	WN ON CORNER
	OCUMENT NUMBER CR-16-			
A description of the phys	ical condition of the monumen	t as found and as s	POJECTED LOT LINE RE	IWFFN LOTS
SET CONCRETE NAIL	WITH BRASS TAG STAMPED	LO O EDOM TIES	AS SHOWN ON PAGE 2	White Edit
108 & 109 OF COLO	NIAL ESTATES NORTH UNIT	NU. Z FROM HES	AS SHOWN ON TAGE 2.	
		a. 20		
	SURVEYOR'S STATEM	IENT		LAND CO
Ti. O December was a	prepared by me or under my o	direction in conformat	ce with	LAND SUPPLY
This Corner Record was p			11 7	KENT A.
the Land Surveyors' Act	on <u>DECEMBER 7</u>		ff ff	1 1
			//*/ /	N□. 6953
1	1		SA	
Signed	P.L.S. or	<del>R.C.E.</del> Number		OF CALFOR
	COUNTY SURVEYOR'S S	TATEMENT		WARREN D SMITH No 4842
This Corner Record was	receivedDecember	2, 2016	and examined	WARREN D
la la	wary 10 , 2017		ll as I	SMITH No 4842
Signed Was	A. A. P.L.S.	or <del>-R.C.E</del> . No: <u>48</u>	42	WS ON
1 8	urveyor			OF CALL
County Surveyor's Comm	ent			194
			100	

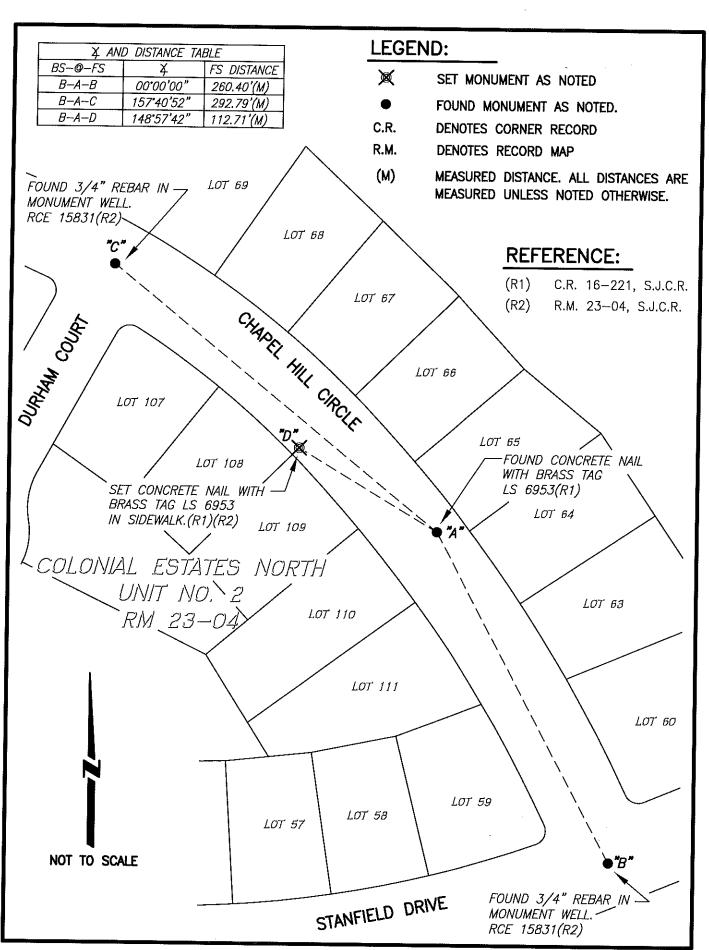

Page 2 of 2