
CORNER RECORD

CORN	ER RECORD	Document	Number <u>OR-17-24</u>
City of	STOCKTON	County of .	SAN JOAQUIN , California
Brief Legal Descri	ption MONUMENTS AT THE PROJE	CTED LOT LINES O	F LOT 106 OF COLONIAL
	ESTATES NORTH UNIT NO.	2. LOCATED IN SEC	CTION 8, T.2N, R.6E, M.D.B.&M. COORDINATES (Optional)
	CORNER TY	PE	N
	Government Corner (Control	E
SEC 8		Property 🔀	
	Rancho	Other	NAD83 Epoch
T ON D OF	Date of Survey11	1-04-16	Elev. Vert. Datum: NVGD29 NVGD88
T.2N, R.6E	Date of Survey		Meas. Units: Metric 🗌 Imperial 💢
Corner- Left	as found Found and tagged	Established	Reestablished 🗶 Rebuilt 📋
Identification and typ	e of corner found: Evidence used to	identify or procedure	e used to establish or reestablish the corne
SET CONCRETE N	AILS WITH BRASS TAGS STAMPED	LS 6953 AT THE F	PROJECTED LOT LINES OF LOT 106 OF
COLONIAL ESTATE	S NORTH UNIT NO. 2. FOUND WIT	NESS CORNERS AS	SHOWN ON CORNER
RECORD FILED AS	DOCUMENT NUMBER CR-16-22	2.	
	2000		
SET CONCRETE N	physical condition of the monument IAILS WITH BRASS TAGS STAMPED S NORTH UNIT NO. 2. FROM TIES	LS 6953 AT THE F	PROJECTED LOT LINES OF LOT 106 OF
	SURVEYOR'S STATEME	NT	e with
This Corner Record	was prepared by me or under my dire	ection in conformance	e with
	Act onDECEMBER 7		HYSELL
the Lana Surveyors	Act on		ND. 6953
Signed	affpu P.L.S. or R.	C.E. Number 69	953 PF OF CALIFORNIA
	COUNTY SURVEYOR'S STA	TEMENT	nd examined WARREN D SMITH
This Corner Record	was receivedDecember 12	2, 2016 a	nd examined WARREN D SMITH
and filed	January 10 , 2017 P.L.S. OF	==	to 4642 tr
Signed	P.L.S. or	R.C.E. No: 4-84	+Z PATE OF CALIFORNIA
3	y Surveyor		
County Surveyor's C	Comment		

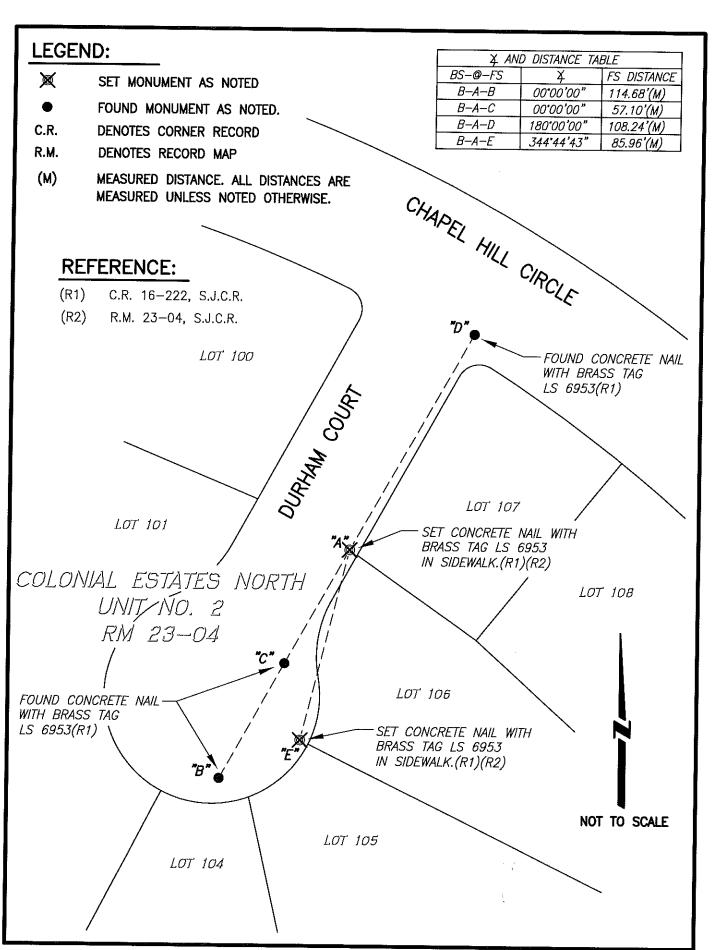

Page 2 of 2