
CORNER RECORD

CORNE	R RECORD	Document	Number <u>CR-17-28</u>
Dity of	STOCKTON	County of .	SAN JOAQUIN , Californi
Brief Legal Descripti	on MONUMENT AT THE PROJECTE	D LOT LINE BET	WEEN LOTS 45 & 46 OF
Silor Logar Boos, pa	UNIT 1 OF PARK WOODS. LO	CATED IN SECTIO	N 17, T.2N, R.6E, M.D.B.&M.
	CORNER TYPE		COORDINATES (Optional)
			N
SEC 17		ntrol 🔲	ENAD27 NAD83
	Meander Pro Rancho Oth		NAD83 Epoch
	Kulicilo	о. <u> </u>	Elev
T.2N, R.6E	Date of Survey11-	04-16	Vert. Datum: NVGD29 NVGD88
TIEN, KIOL			Meas. Units: Metric 🗌 Imperial 🔀
Corner— Left as	found Found and tagged	Established	Reestablished 🔀 Rebuilt 🗌
dentification and type	of corner found: Evidence used to ic	lentify or procedure	e used to establish or reestablish the corr
SET CONCRETE NAIL	. WITH BRASS TAG STAMPED LS 6	953 AT THE PRO	OJECTED LOT LINE BETWEEN LOTS
45 & 46 OF UNIT	1 OF PARK WOODS. FOUND WITNE	ESS CORNERS AS	S SHOWN ON CORNER
RECORD FILED AS I	DOCUMENT NUMBER CR-16-227.		
	nysical condition of the monument as	found and as set	or reset:
A description of the pr	WITH PRASS TAG STAMPED IS A	953 AT THE PRO	OJECTED LOT LINE BETWEEN LOTS
	1 OF PARK WOODS FROM TIES A		
45 & 46 UF UNII	TOF PARK WOODS TROM HES A	5 SHOWN ON TE	100 -
	SURVEYOR'S STATEMENT		e with
This Corner Record was	s prepared by me or under my direct	ion in conformance	e with
		2016	HYSELL \
the Land Surveyors' Ac	t onDECEMBER /	,,	ND. 6953
			*
1	/	04	953 OF CALFORNIA
Signed	P.L.S. or R.C.E	: Number69	
	COUNTY SURVEYOR'S STATE	MENT	and examined warren D SMITH No 4842
This Corner Record wa	s received December 12_	, 2016 a	und examined WARREN D
	muary 10 , 2017		© No 4842
Signed Way		C.E . No: <u>4-84</u>	+2 0 W
	Surveyor		OF CAL
,	nment		
Source Surveyor S Son			
-			

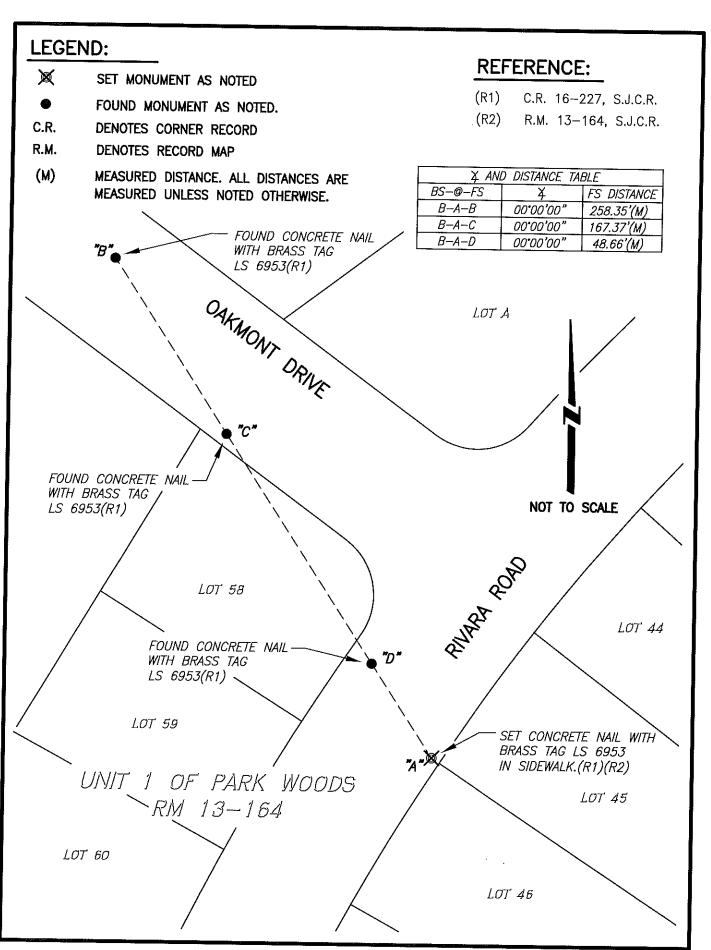

Page 2 of 2