
## **CORNER RECORD**

CORNE	R RECORD	Document N	Number <u>OR-17-29</u>
City of	STOCKTON	County of _	SAN JOAQUIN , Californi
Brief Legal Descript	ion MONUMENT AT THE NORTHERI	LY RETURN OF LO	OT 1170 OF LINCOLN VILLAGE
	WEST, UNIT NO. 23 LOCATED	IN SECTION 19,	T.2N, R.6E, M.D.B.&M.
	CORNER TYPE		COORDINATES (Optional)
•	Government Corner Corner	ntrol 🔲	N
SEĆ 19		pperty 🔀	ENAD27  NAD83
	Rancho Oth	ner 🔲	NAD83 Epoch
	14	04 16	Elev.  Vert. Datum: NVGD29 NVGD88
T.2N, R.6E	Date of Survey11-	04-16	Meas. Units: Metric   Imperial
Corner— Left as	found Found and tagged	Established	Reestablished 🗶 Rebuilt 🗌
Identification and type	of corner found: Evidence used to id	dentify or procedure	used to establish or reestablish the corn
SET CONCRETE NA	L WITH BRASS TAG STAMPED LS 6	953 AT THE NOR	RTHERLY RETURN OF LOT 1170
	E WEST, UNIT NO. 23. FOUND WIT		
	DOCUMENT NUMBER CR-16-228.		
1120112	8		
	6.11	found and as set	or reget
A description of the	physical condition of the monument as IL WITH BRASS TAG STAMPED LS (	Tound and as set SO53 AT THE NOR	THERLY RETURN OF LOT 1170
OF LINCOLN VILLAC	SE WEST, UNIT NO. 23 FROM TIES	AS SHOWN ON F	-AGE 2.
		· · · · · · · · · · · · · · · · · · ·	
	SURVEYOR'S STATEMENT	•	LAND DE
This Corner Pecord wa	ıs prepared by me or under my direct	ion in conformance	with
			KENT A. HYSELL
the Land Surveyors' A	ct onDECEMBER 7	, <u>2016</u> ,	ND, 6953
			★   NL. 8933  ★
1	/		SATE
Signed	P.L.S. or <del>R.C.!</del>	Number69	
	COUNTY SURVEYOR'S STATE	MENT	nd examined WARREN D SMITH No 4842
This Corner Record wo	as received December 12_	, 2016 an	nd examined WARREN D SMITH
			No 4842
A 1	P.L.S. or R.	C-E No: 4-84	Month we to
Signed		6.E. No	PIE OF CALIFORN
	Surveyor		
County Surveyor's Co	mment		
-			

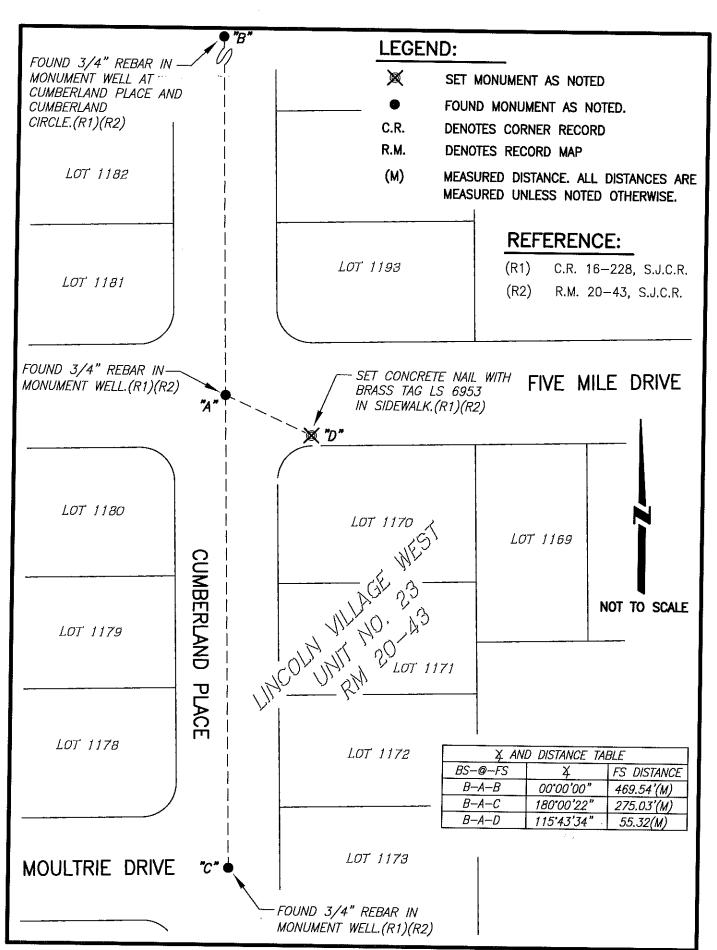

Page 2 of 2