


# CORNER RECORD

Document Number CR-17-30

City of STOCKTON

County of SAN JOAQUIN, California

Brief Legal Description MONUMENT AT THE PROJECTED LOT LINE BETWEEN LOTS 2126 & 2127 OF LINCOLN VILLAGE WEST, UNIT NO. 41 LOCATED IN SECTION 19, T.2N, R.6E, M.D.B.&M.

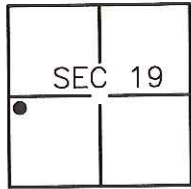

T.2N, R.6E

### CORNER TYPE

Government Corner  Control   
 Meander  Property   
 Rancho  Other

Date of Survey 11-04-16

### COORDINATES (Optional)

N \_\_\_\_\_  
 E \_\_\_\_\_  
 Zone \_\_\_\_\_ NAD27  NAD83   
 NAD83 Epoch \_\_\_\_\_  
 Elev. \_\_\_\_\_  
 Vert. Datum: NVGD29  NVGD88   
 Meas. Units: Metric  Imperial

Corner— Left as found  Found and tagged  Established  Reestablished  Rebuilt

Identification and type of corner found: Evidence used to identify or procedure used to establish or reestablish the corner:  
SET CONCRETE NAIL WITH BRASS TAG STAMPED LS 6953 AT THE PROJECTED LOT LINE BETWEEN LOTS 2126 & 2127 OF LINCOLN VILLAGE WEST, UNIT NO. 41. FOUND WITNESS CORNERS AS SHOWN ON CORNER RECORD FILED AS DOCUMENT NUMBER CR-16-229.

A description of the physical condition of the monument as found and as set or reset:  
SET CONCRETE NAIL WITH BRASS TAG STAMPED LS 6953 AT THE PROJECTED LOT LINE BETWEEN LOTS 2126 & 2127 OF LINCOLN VILLAGE WEST, UNIT NO. 41 FROM TIES AS SHOWN ON PAGE 2.

### SURVEYOR'S STATEMENT

This Corner Record was prepared by me or under my direction in conformance with the Land Surveyors' Act on DECEMBER 7, 2016,



Signed [Signature] P.L.S. or R.C.E. Number 6953

### COUNTY SURVEYOR'S STATEMENT

This Corner Record was received December 12, 2016 and examined and filed January 10, 2017

Signed [Signature] P.L.S. or R.C.E. No: 4842



Title County Surveyor


County Surveyor's Comment \_\_\_\_\_  
 \_\_\_\_\_  
 \_\_\_\_\_

**LEGEND:**

- ⊗ SET MONUMENT AS NOTED
- FOUND MONUMENT AS NOTED.
- C.R. DENOTES CORNER RECORD
- R.M. DENOTES RECORD MAP
- (M) MEASURED DISTANCE. ALL DISTANCES ARE MEASURED UNLESS NOTED OTHERWISE.



NOT TO SCALE

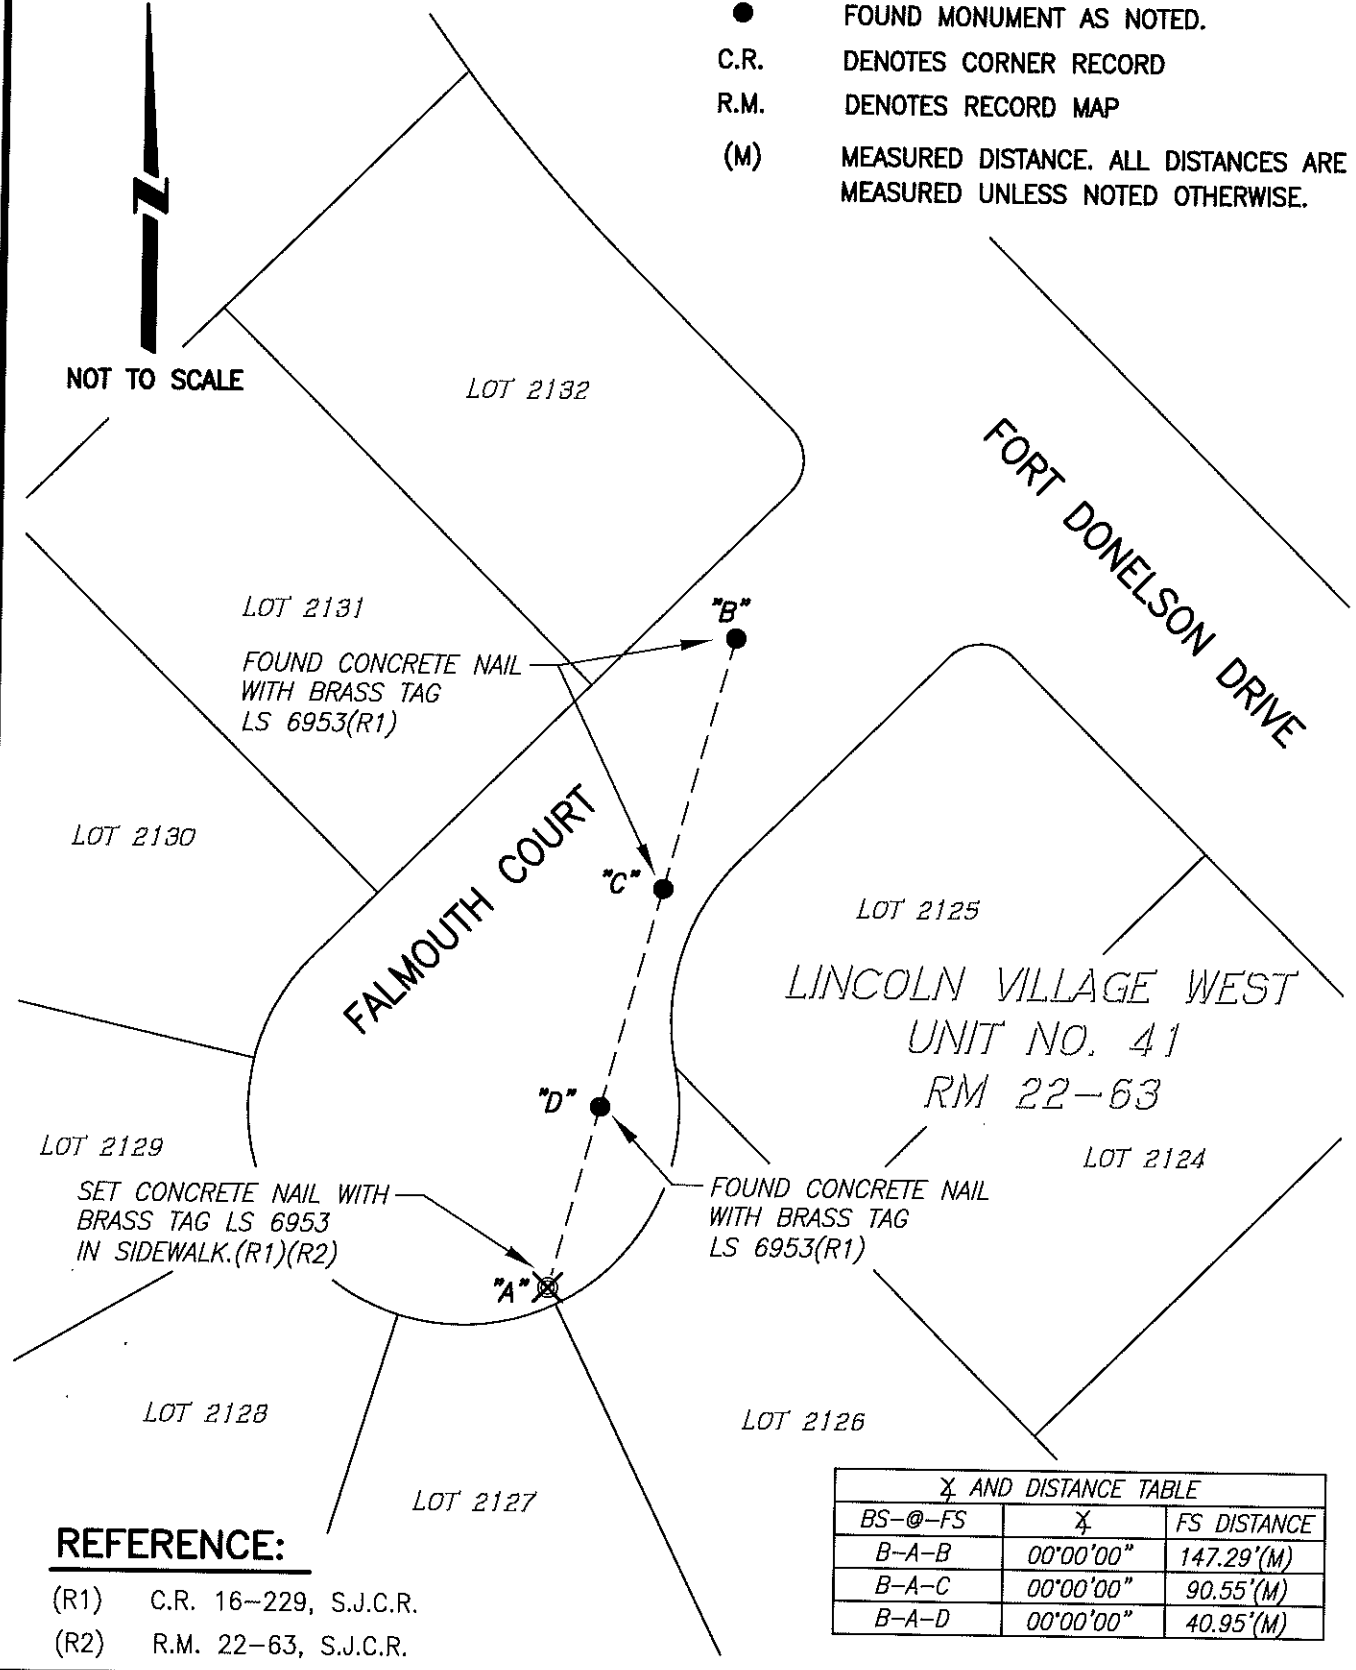

**REFERENCE:**

- (R1) C.R. 16-229, S.J.C.R.
- (R2) R.M. 22-63, S.J.C.R.

⊗ AND DISTANCE TABLE		
BS-@-FS	⊗	FS DISTANCE
B-A-B	00°00'00"	147.29'(M)
B-A-C	00°00'00"	90.55'(M)
B-A-D	00°00'00"	40.95'(M)