
## **CORNER RECORD**

CORNER RECORD	Document Number CR-17-32
City of STOCKTON	County of SAN JOAQUIN, California
Brief Legal Description MONUMENT AT THE SOUTHERLY	RETURN OF LOT 378 OF WEBERSTOWN UNIT NO. 5
LOCATED IN SECTION 16 OF THE C. M. WEBER GRANT.	
CORNER TYPE	N
Government Corner Contro	
Meander Proper	
Rancho Other	NAD83 Epoch
Date of Survey12-01	Elev
Date of Survey	Meas. Units: Metric 🗌 Imperial 🗹
Corner— Left as found [ Found and tagged [ Established [ Reestablished <b>X</b> Rebuilt [	
Identification and type of corner found: Evidence used to identify or procedure used to establish or reestablish the corner:	
SET CONCRETE NAIL WITH BRASS TAG STAMPED LS 6953 AT THE SOUTHERLY RETURN OF LOT 378	
OF WEBERSTOWN UNIT NO. 5. FOUND WITNESS CORNERS AS SHOWN ON CORNER RECORD FILED	
AS DOCUMENT NUMBER CR-16-231.	
A description of the physical condition of the monument as found and as set or reset:	
SET CONCRETE NAIL WITH BRASS TAG STAMPED LS 6953 AT THE SOUTHERLY RETURN OF LOT 378	
OF WEBERSTOWN UNIT NO. 5 FROM TIES AS SHOWN ON PAGE 2.	
SURVEYOR'S STATEMENT	
SURVEYOR'S STATEMENT  This Corner Record was prepared by me or under my direction in conformance with  KENT A.	
the Land Surveyors' Act on	
the Land Surveyors Act on	
	*
Signed P.L.S. or R.C.E.	Number 6953
Signed P.L.S. or R.C.E.	Number
COUNTY SURVEYOR'S STATEME	153
This Corner Record was received December 12,_	2016 and examined SMITH
and filed	
Signed Na A. J. P.L.S. or-R.C.E	No: 4842
Title County Surveyor	
County Surveyor's Comment	

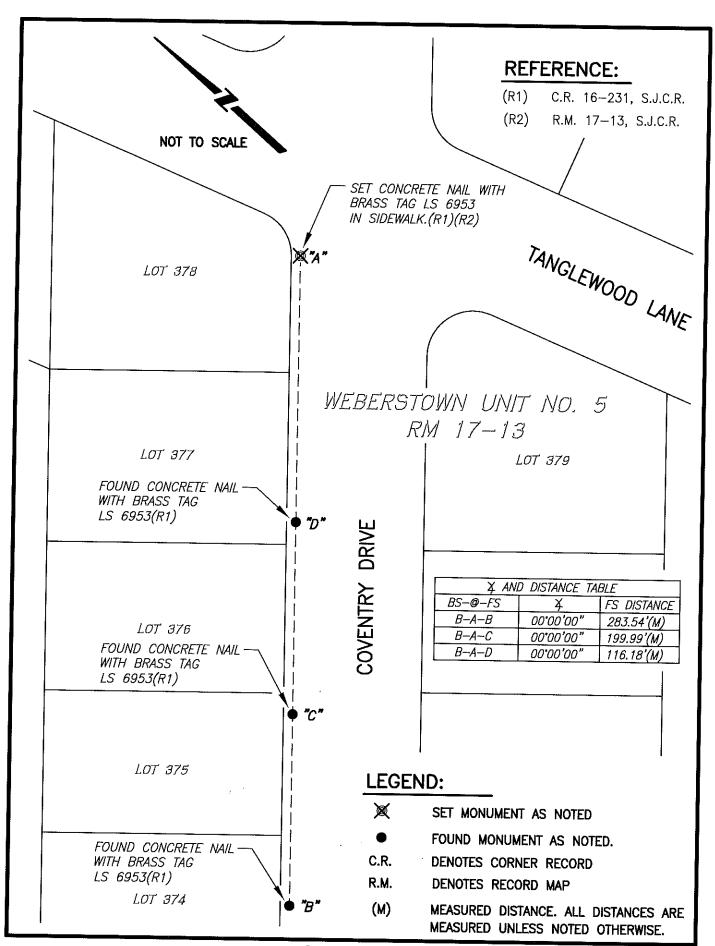

Page 2 of 2