


# CORNER RECORD

Document Number CR-17-33  
County of SAN JOAQUIN, California

City of STOCKTON

Brief Legal Description MONUMENT AT THE PROJECTED LOT LINE BETWEEN LOTS 26 & 27 OF VISTA DEL RIO  
UNIT NO. 2 LOCATED IN SECTION 32, T.2N, R.6E, M.D.B.&M.

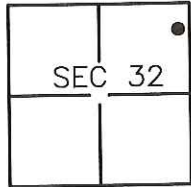

T.2N, R.6E

## CORNER TYPE

Government Corner ☐ Control ☐  
Meander ☐ Property ☒  
Rancho ☐ Other ☐

Date of Survey 12-01-16

## COORDINATES (Optional)

N \_\_\_\_\_  
E \_\_\_\_\_  
Zone \_\_\_\_\_ NAD27 ☐ NAD83 ☐  
NAD83 Epoch \_\_\_\_\_  
Elev. \_\_\_\_\_  
Vert. Datum: NVGD29 ☐ NVGD88 ☐  
Meas. Units: Metric ☐ Imperial ☒

Corner— Left as found ☐ Found and tagged ☐ Established ☐ Reestablished ☒ Rebuilt ☐

Identification and type of corner found: Evidence used to identify or procedure used to establish or reestablish the corner:

SET CONCRETE NAIL WITH BRASS TAG STAMPED LS 6953 AT THE PROJECTED LOT LINE BETWEEN LOTS  
26 & 27 OF VISTA DEL RIO, UNIT NO. 2. FOUND WITNESS CORNERS AS SHOWN ON CORNER RECORD  
FILED AS DOCUMENT NUMBER CR-16-232.

A description of the physical condition of the monument as found and as set or reset:

SET CONCRETE NAIL WITH BRASS TAG STAMPED LS 6953 AT THE PROJECTED LOT LINE BETWEEN LOTS  
26 & 27 OF VISTA DEL RIO, UNIT NO. 2 FROM TIES AS SHOWN ON PAGE 2.

## SURVEYOR'S STATEMENT

This Corner Record was prepared by me or under my direction in conformance with  
the Land Surveyors' Act on DECEMBER 7, 2016,

Signed [Signature] P.L.S. or R.C.E. Number 6953



## COUNTY SURVEYOR'S STATEMENT

This Corner Record was received December 12, 2016 and examined  
and filed January 10, 2017

Signed Warren D. Smith P.L.S. or R.C.E. No: 4842

Title County Surveyor


County Surveyor's Comment \_\_\_\_\_



# LEGEND:

- ⊗ SET MONUMENT AS NOTED
- FOUND MONUMENT AS NOTED.
- C.R. DENOTES CORNER RECORD
- R.M. DENOTES RECORD MAP
- (M) MEASURED DISTANCE. ALL DISTANCES ARE MEASURED UNLESS NOTED OTHERWISE.

X AND DISTANCE TABLE		
BS-@-FS	X	FS DISTANCE
B-A-B	00°00'00"	175.92'(M)
B-A-C	00°00'00"	120.59'(M)
B-A-D	00°00'00"	69.59'(M)

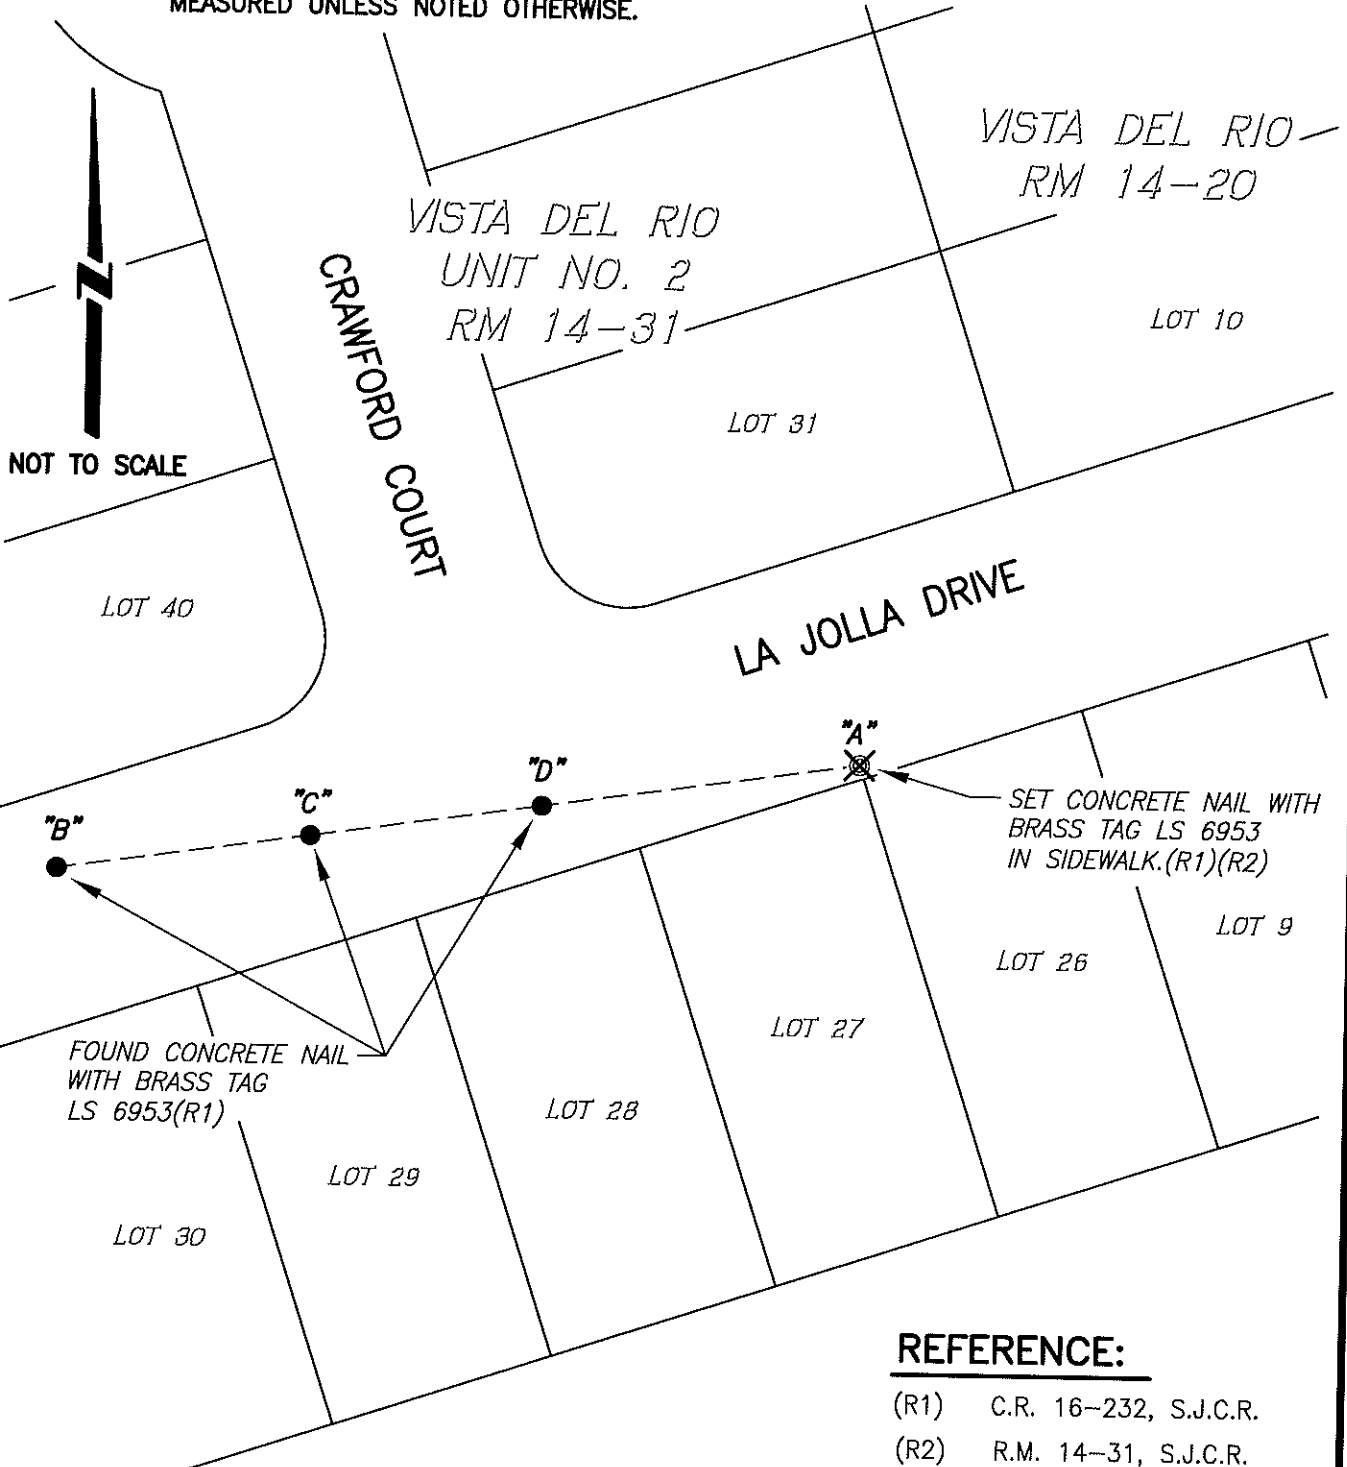

## REFERENCE:

- (R1) C.R. 16-232, S.J.C.R.
- (R2) R.M. 14-31, S.J.C.R.