
CORNER RECORD

		Document N	Number	14-54
City of		County of	San Joaquin	, California
Brief Legal Description	The 2.350 Ac. Parcel show	n on R.S. 12-205, S.J.	.C.R.	
			r (ONOR CLUB) (MI a fr	
	CORNER TY	YPE	COORDINA	ATES(Optional)
X			N	V
	Government Corner	Control	E	1
	Meander	Property	Zone	NAD27
	Rancho	Other	NAD83 Epoch	
			Elev.	
Sec. 22, T. 2S., R.4E.,	Date of Survey Septembe	er 23, 2016	Vert. Datum: NGVI	
M.D.B.&M.	A		Meas. Units: Metric	lmperial 🗶
Corner - Left as found	Found and tagged	Established X	Reestablished	Rebuilt
Identification and two of com-	er found: Evidence used to ide	ntify or procedure used t	o ostablish or roostablish	sh the corner
See Sheet 2	51 Tourid. Evidence used to ide	nuly of procedure used to	o establisti di Teestablis	on the comer.
See Sheet 2				
-	· · · · · · · · · · · · · · · · · · ·			
N.		'		
	4			X.
A description of the physical of	ondition of the monument as fo	ound and as set or reset:		
See Sheet 2	oridition of the monument as it	Juliu aliu as set of leset.	-	
Oce officer 2				
3				
	SURVEYOR'S STATEME	ENT	£5510h	AL LAND STA
			St. cha	al L. Quarte
the Land Surveyor's Act on Dec. 8 , 2016 . No. 4450 SEAL				
Signed free Luntage L.S. or R.C.E. No.: L.S. 4450				
Signed rue C	Mangar R.M.S. or R.	.C.E. No.: _ L.S. 44	50	Alle.
V			TE (F CALIFORNIA
	COUNTY SURVEYOR'S STA	TEMENT		
	0	2011		WARREN D SMITH No 4842
This Corner Record was recei	ved <u>December ?</u>	ar 2016	nd examined	WARREN D 3
and filed Januar	Y 10 2017	•	##	SMITH 39
Signed Mar A	1 4	R.C.E. No.: 484	12	We Is
		N.O.L. NO	1,5	* 18°
Title County Sor	leyor			COFCALO
County Surveyor's Comm	nent			10 November 1.
			tion with the supervision magn	
		8.0		
			-	

BORPELS - 1297

Page 1 of 2

Job No. 2016-149

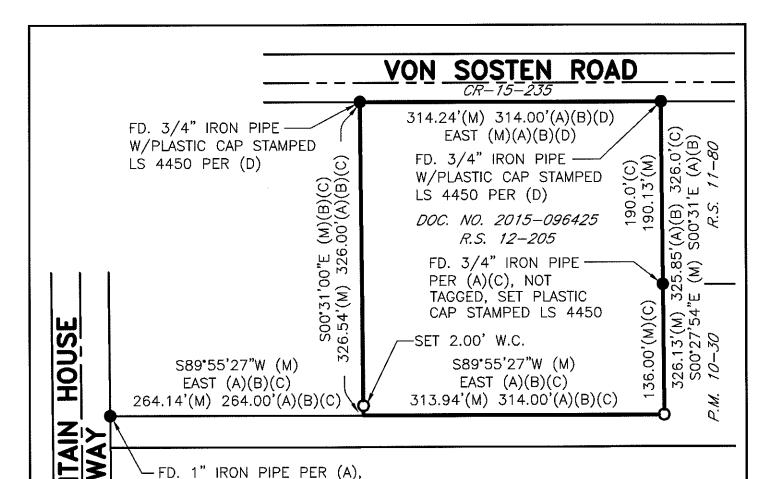

LEGEND

INDICATES FOUND MONUMENT AS NOTED.

INDICATES SET 3/4" X 30" IRON PIPE W/PLASTIC CAP STAMPED LS 4450 INDICATES FOUND ON THIS SURVEY

FD.

NOT TAGGED, SET PLASTIC CAP STAMPED LS 4450

INDICATES RECORD OF SURVEY, BOOK AND PAGE, S.J.C.R. INDICATES PARCEL MAP, BOOK AND PAGE, S.J.C.R. R.S.

P.M.

C.R. INDICATES CORNER RECORD, S.J.C.S.R.

S.J.C.S.R. INDICATES SAN JOAQUIN COUNTY SURVEYORS RECORDS

S.J.C.R. INDICATES SAN JOAQUIN COUNTY RECORDS

W.C. INDICATES WITNESS CORNER

(M)INDICATES MEASURED ON THIS SURVEY

REFERENCES

(A) P.M. 10-38, S.J.C.R.

(B) R.S. 12-205, S.J.C.R.

(C) R.S. 11-80, S.J.C.R.

(D) CR-15-235, S.J.C.S.R.



SCALE: 1" = 100'2016-149