


CORNER RECORD

Document Number CR-17-75

City of Stockton

County of San Joaquin, California

Brief Legal Description Projection of North lot line of Lot 25, 22 M.P. 47 at the East end thereof.

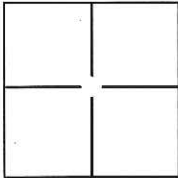

CORNER TYPE

Government Corner Control
Meander Property
Rancho Other

Date of Survey January 24, 2017

COORDINATES(Optional)

N. _____
E. _____
Zone _____ NAD27 NAD83
NAD83 Epoch _____
Elev. _____
Vert. Datum: NGVD29 NADV88
Meas. Units: Metric Imperial

Corner - Left as found Found and tagged Established Reestablished Rebuilt

Identification and type of corner found: Evidence used to identify or procedure used to establish or reestablish the corner:

The location of the cut cross was reestablished based on found monuments and record coordinates per
Corner Record 16-52.

A description of the physical condition of the monument as found and as set or reset: Set 1" brass disc stamped "LS 6947" in
concrete sidewalk.

SURVEYOR'S STATEMENT

This Corner Record was prepared by me or under my direction in conformance with
the Land Surveyor's Act on January 27, 2017.

Signed [Signature] P.L.S. or R.C.E. No.: L.S. 6947



COUNTY SURVEYOR'S STATEMENT


This Corner Record was received February 2, 2017 and examined
and filed February 15, 2017.

Signed [Signature] P.L.S. or R.C.E. No.: 4842


Title County Surveyor

County Surveyor's Comment _____



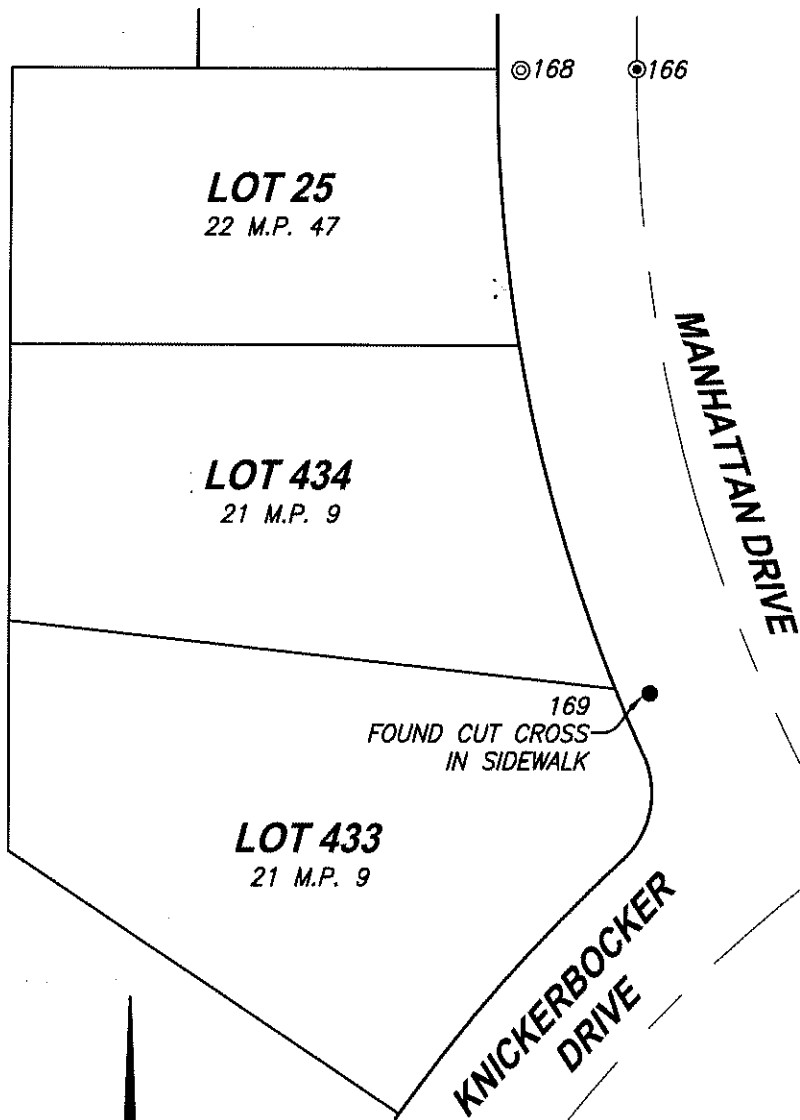

COORDINATES PER CR-16-52		
POINT #	NORTHING	EASTING
166	2196476.93	6331846.17
168	2196476.95	6331821.10
165	2196307.52	6331892.76
169	2196341.83	6331849.35

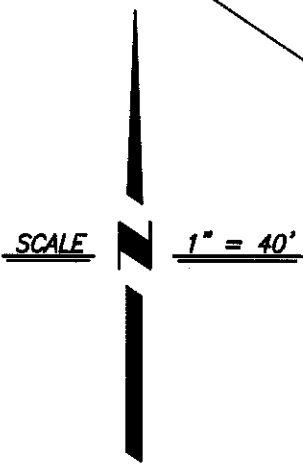


LEGEND:

- ⊙ - - SET 1" BRASS DISC "LS 6947" IN SIDEWALK BASED ON THE COORDINATES LISTED ON CORNER RECORD 16-52.
- ⊙ - - FOUND 3/4" IRON PIPE IN MONUMENT WELL PER 22 M.P. 47
- - - FOUND MONUMENT AS NOTED
- M.P. - - MAPS & PLATS

NOTE: NO ATTEMPT WAS MADE TO VERIFY MONUMENT

CenterPoint Engineering, Inc.

Civil Engineering & Land Surveying
 1217 Pleasant Grove Blvd, Suite 130 • Roseville, CA • 95678
 Phone: 916-773-4006 Fax: 916-773-4498

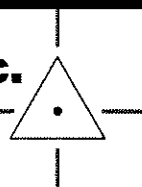

DRAWN BY: BB
CHECKED BY: MH
SHEET: 2 OF 2
SCALE: 1" = 40'
DATE: 1-27-2017