


# CORNER RECORD

Document Number CR-17-79

City of Lathrop

County of San Joaquin, California

Brief Legal Description Lots 27, 28, and 29, Block 73, of Volume 1 Maps & Plats, Page 68, S.J. County.

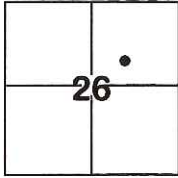

T. 1 S., R. 6 E., M.D.B.&M.

### CORNER TYPE

Government Corner  Control   
 Meander  Property   
 Rancho  Other

Date of Survey January 6, 2017

### COORDINATES(Optional)

N. \_\_\_\_\_  
 E. \_\_\_\_\_  
 Zone \_\_\_\_\_ NAD27  NAD83   
 NAD83 Epoch \_\_\_\_\_  
 Elev. \_\_\_\_\_  
 Vert. Datum: NGVD29  NADV88   
 Meas. Units: Metric  Imperial

Corner - Left as found  Found and tagged  Established  Reestablished  Rebuilt

Identification and type of corner found: Evidence used to identify or procedure used to establish or reestablish the corner:


See sketch.

A description of the physical condition of the monument as found and as set or reset: See sketch.

### SURVEYOR'S STATEMENT

This Corner Record was prepared by me or under my direction in conformance with the Land Surveyor's Act on January 6, 2017.

Signed Joe Murphy P.L.S. or R.C.E. No.: L.S. 7269

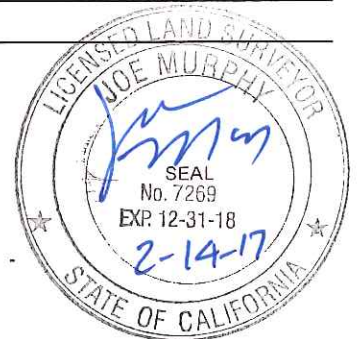


### COUNTY SURVEYOR'S STATEMENT


This Corner Record was received February 15, 2017 and examined and filed March 9, 2017.

Signed Wan D. Smith P.L.S. or R.C.E. No.: 4842

Title County Surveyor

County Surveyor's Comment \_\_\_\_\_

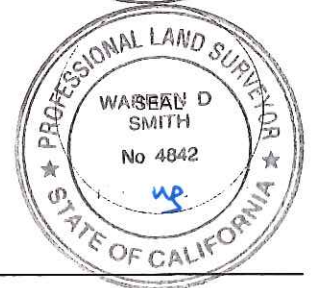

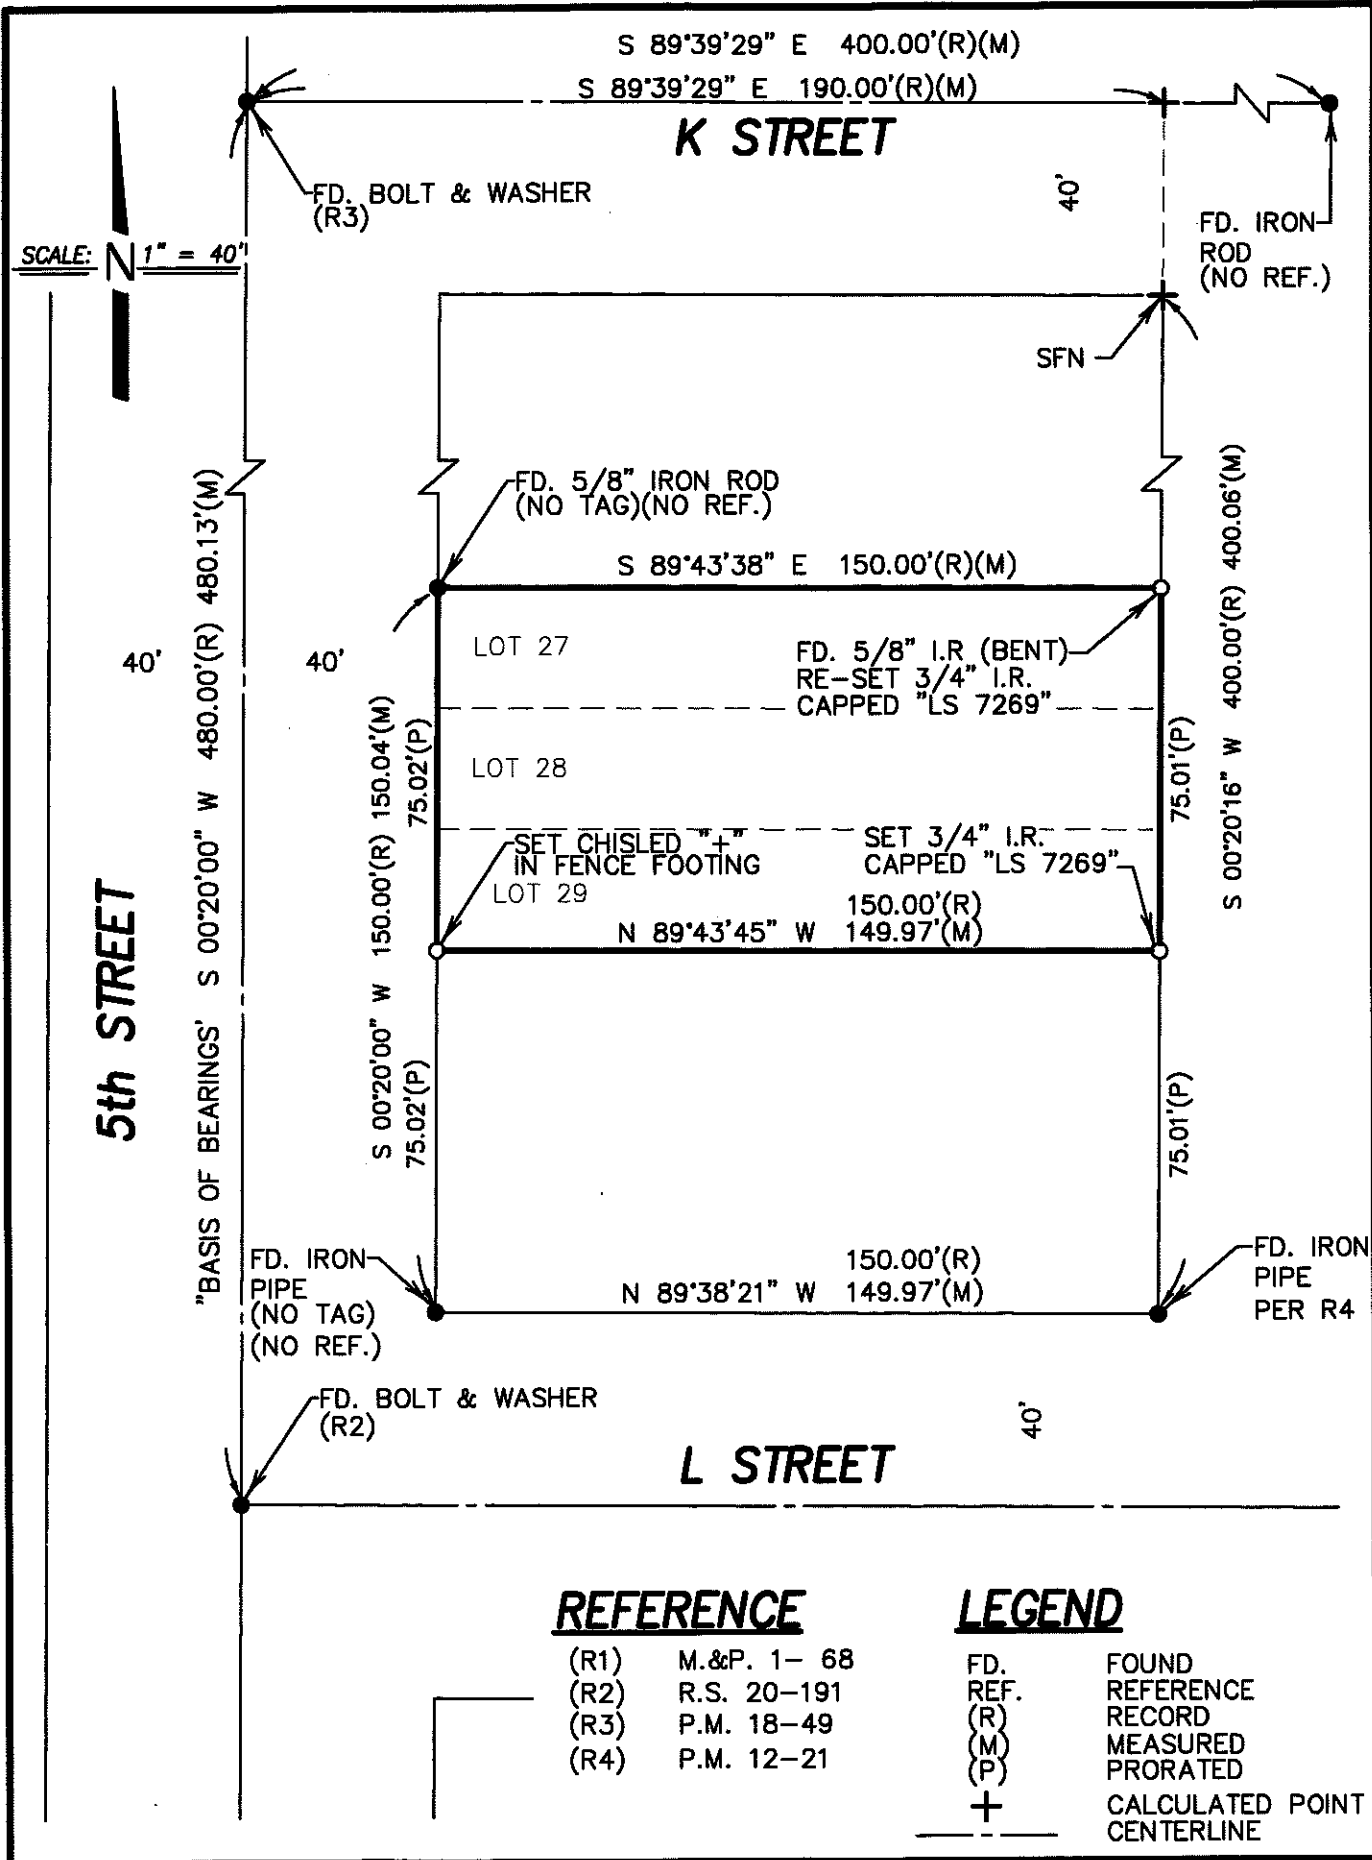

S 89°39'29" E 400.00'(R)(M)  
 S 89°39'29" E 190.00'(R)(M)

**K STREET**

SCALE: 1" = 40'

**5th STREET**

"BASIS OF BEARINGS" S 00°20'00" W 480.00'(R) 480.13'(M)

FD. BOLT & WASHER (R3)

FD. IRON ROD (NO REF.)

FD. 5/8" IRON ROD (NO TAG)(NO REF.)

S 89°43'38" E 150.00'(R)(M)

LOT 27

FD. 5/8" I.R. (BENT)  
 RE-SET 3/4" I.R.  
 CAPPED "LS 7269"

LOT 28

SET CHISELED "+"  
 IN FENCE FOOTING  
 LOT 29

SET 3/4" I.R.  
 CAPPED "LS 7269"

N 89°43'45" W 149.97'(M)

FD. IRON PIPE (NO TAG) (NO REF.)

150.00'(R)  
 N 89°38'21" W 149.97'(M)

FD. IRON PIPE PER R4

FD. BOLT & WASHER (R2)

**L STREET**

**REFERENCE**

- (R1) M.&P. 1- 68
- (R2) R.S. 20-191
- (R3) P.M. 18-49
- (R4) P.M. 12-21

**LEGEND**

- FD. FOUND
- REF. REFERENCE
- (R) RECORD
- (M) MEASURED
- (P) PRORATED
- + CALCULATED POINT
- - - CENTERLINE