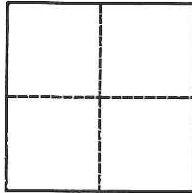


CORNER RECORD

Agency Index CR-17-132

Document Number _____

City of Tracy County of San Joaquin, CaliforniaBrief Legal Description Monument Northeastly Corner of Lot 24 per 10-M-44.**CORNER TYPE****COORDINATES (Optional)**

Government Corner Control Elevation
 Meander Property Units
 Rancho Other Horizontal Datum

N. _____ E. _____

Elevation _____

Units Metric U.S. Survey Foot

Horizontal Datum _____

Zone _____ Epoch Date _____

Date of Survey March 31, 2017

Vertical Datum _____

 Complies with Public Resources Code §§8801-8819 Complies with Public Resources Code §§8890-8902PLS Act Ref.: 8765(d) 8771 8773 Other:Corner/Monument: Left as found Established Rebuilt Pre-Construction Found and tagged Reestablished Referenced Post-Construction


Narrative of corner identified and monument as found, set, reset, replaced, or removed:

 See sheet #2 for description(s):

Found Iron Rod in pavement.

SURVEYOR'S STATEMENT

This Corner Record was prepared by me or under my direction in conformance with

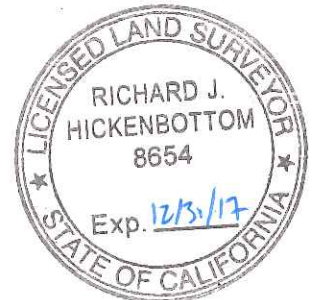the Professional Land Surveyors' Act on April 3, 2017Signed Richard J. Hickenbottom P.L.S. or R.C.E. No. 8654**COUNTY SURVEYOR'S STATEMENT**This Corner Record was received April 17, 2017and examined and filed May 18, 2017Signed Warren D. Smith P.L.S. or R.C.E. No. 4842Title County Surveyor

County Surveyor's Comment





LEGEND

- ⊗ SET NAIL W/ TAG "LS8654"
- SET IRON PIPE W/ PLUG "LS8654"
- ⊙ MONUMENT
- PP POWER POLE
- SFNF SEARCHED FOR NOT FOUND
- TB TELEPHONE BOX
- EDGE OF PAVEMENT
- CENTERLINE
- BOUNDARY LINE
- MONUMENT TIE LINE
- TOP OF BANK

LOT 24
 MAP OF UNIT NO. 1
 PESCADERO COLONY
 10 M 44

LOT 37
 MAP OF UNIT NO. 1
 PESCADERO COLONY
 10 M 44

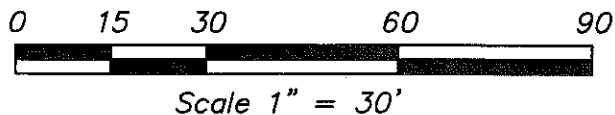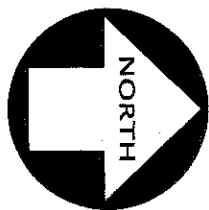

SFNF
 NORTHWESTERLY
 CORNER LOT 24
 PER 10 M 44

FOUND IRON ROD
 NORTHEASTERLY
 CORNER LOT 24
 PER 10 M 44

SFNF
 NORTHEASTERLY
 CORNER LOT 37
 PER 10 M 44

ARBOR AVENUE

DITCH

DITCH

PP

DITCH

DITCH

