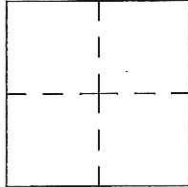


CORNER RECORD

Agency Index CR-17-145
 Document Number _____

City of _____ County of San Joaquin, California

Brief Legal Description Kingdon Road 1332'± east of Thornton Road
 Within Section 13, Township 3 North, Range 5 East, Mount Diablo Base & Meridian

| CORNER TYPE | COORDINATES (Optional) |
|---|---|
|  | N. _____ E. _____ |
| | Government Corner <input type="checkbox"/> Control <input type="checkbox"/> Elevation. _____ |
| | Meander <input type="checkbox"/> Property <input type="checkbox"/> Units Metric <input type="checkbox"/> U.S. Survey Foot <input checked="" type="checkbox"/> |
| | Rancho <input type="checkbox"/> Other <input checked="" type="checkbox"/> Horizontal Datum _____ |
| Date of Survey <u>March 29, 2017</u> | Zone _____ Epoch Date _____ |
| | Vertical Datum _____ |
| | <input type="checkbox"/> Complies with Public Resources Code §§8801-8819 |
| | <input type="checkbox"/> Complies with Public Resources Code §§8890-8902 |

| | | | | |
|----------------------|---|--|-------------------------------------|--|
| PLS Act Ref.: | <input type="checkbox"/> 8765(d) | <input checked="" type="checkbox"/> 8771 | <input type="checkbox"/> 8773 | <input type="checkbox"/> Other: |
| Corner/ Monument: | <input checked="" type="checkbox"/> Left as found | <input type="checkbox"/> Established | <input type="checkbox"/> Rebuilt | <input checked="" type="checkbox"/> Pre-Construction |
| | <input type="checkbox"/> Found and tagged | <input type="checkbox"/> Reestablished | <input type="checkbox"/> Referenced | <input type="checkbox"/> Post-Construction |

Narrative of corner identified and monument as found, set, reset, replaced, or removed:
 See sheet #2 for description(s):

SURVEYOR'S STATEMENT

This Corner Record was prepared by me or under my direction in conformance with
 the Professional Land Surveyor's Act on May 15, 2017

Signed James E. Hart P.L.S. or R.C.E. No. 8657



COUNTY SURVEYOR'S STATEMENT

This Corner Record was received May 16, 2017
 and examined and filed June 5, 2017


Signed Warren D. Smith P.L.S. or R.C.E. No. 4842
 Title County Surveyor

County Surveyor's Comment





N.T.S.

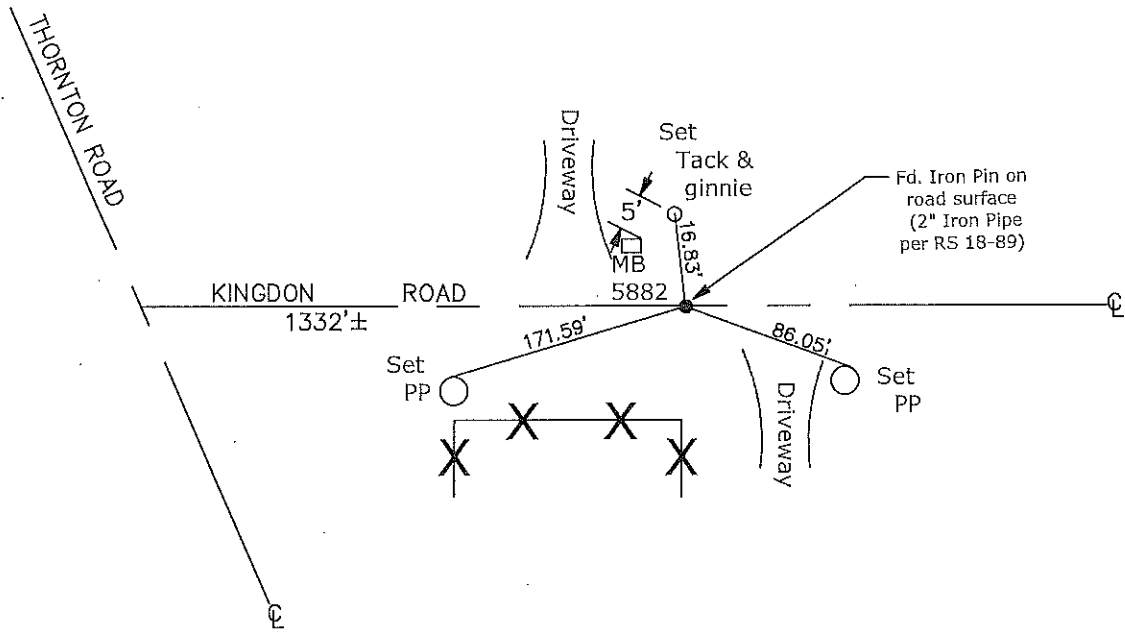

- CR=Corner Record
- FP=Fence Post
- JP=Joint Pole
- LP=Light Pole
- PP=Power Pole
- GP=Guy Pole
- SP=Service Pole
- TP=Telephone Pole
- S.F.N.=Searched Found Nothing
- N.T.S.=Not To Scale
- M&P=Maps & Plats
- PM=Parcel Map
- RS=Record of Survey
- FB=Field Book
- N=North
- DI=Drain Inlet
- TOC=Top of Curb

Set=Conc. Nail with Brass Washer Stamped
 "S.J. Co.", unless otherwise noted
 Fd.=Found Conc. Nail with Brass Washer Stamped
 "S.J. Co.", unless otherwise noted
 Note: Found Monuments are not tagged
 unless otherwise noted.

"No Attempt Was Made to Verify the Monument(s)"